


LOTS 27 & 28 BLOCK 1
BERGHOLTZ'S SUB. OF LOTS 2, 6, 10, 11, 14 & 15
BAZILLE'S ACRE LOTS

Surveyed May 10th 1902

scale 20 feet per inch

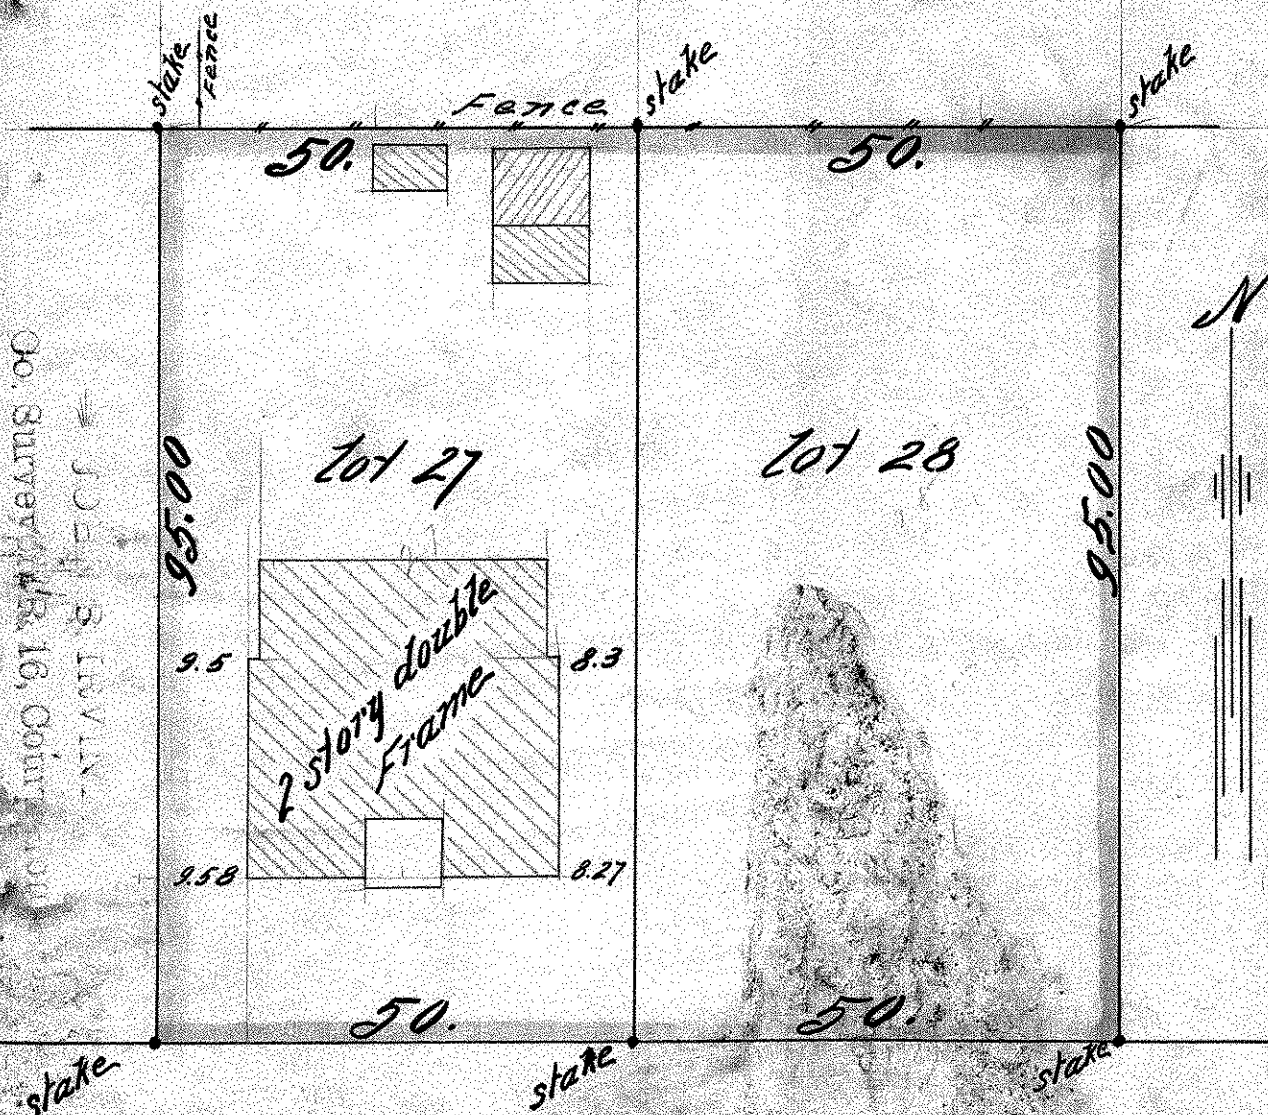

JOHN B. IRVING
Co. Surveyor, R. 16, Co. 10

LITCHFIELD ST

1 B. 47, P. 9