

LOT. 3. BLOCK. 3.

BIRMINGHAM PARK

May 1905


JOHN B. IRVINE, SURVEYOR

ROOM 508 GLOBE BLDG.

SCALE 1 IN. = 20 FT.

ST. PAUL MINN.

BRAND ST.

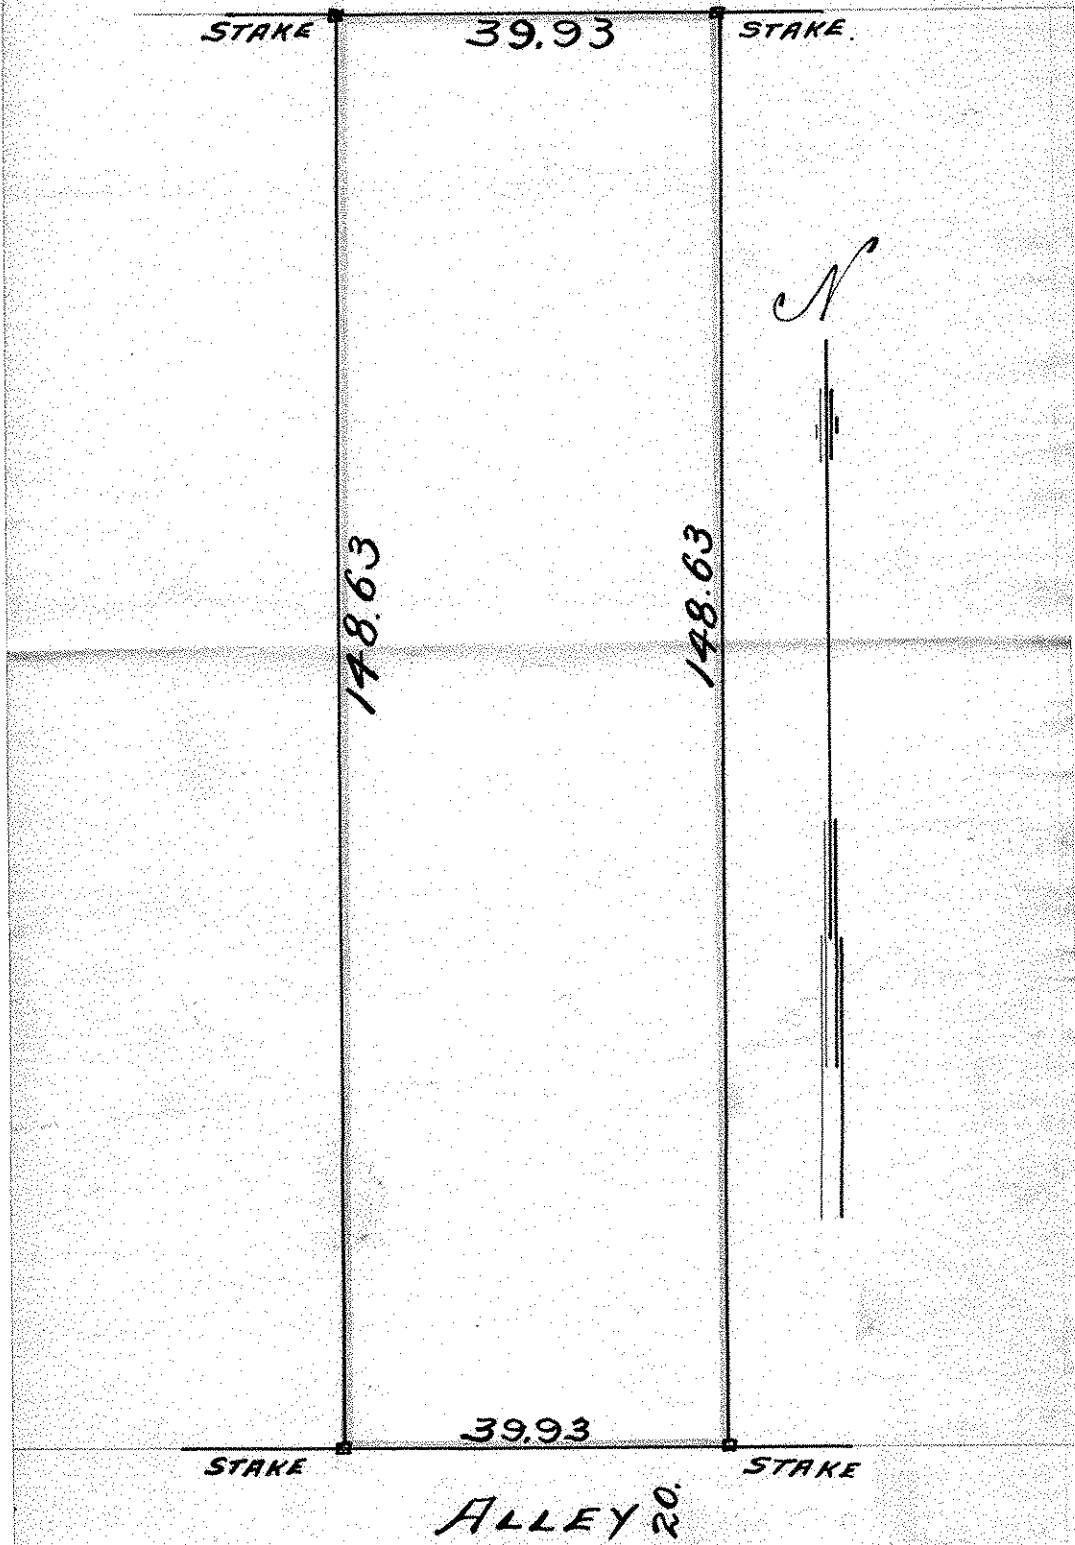

MAY 19-05