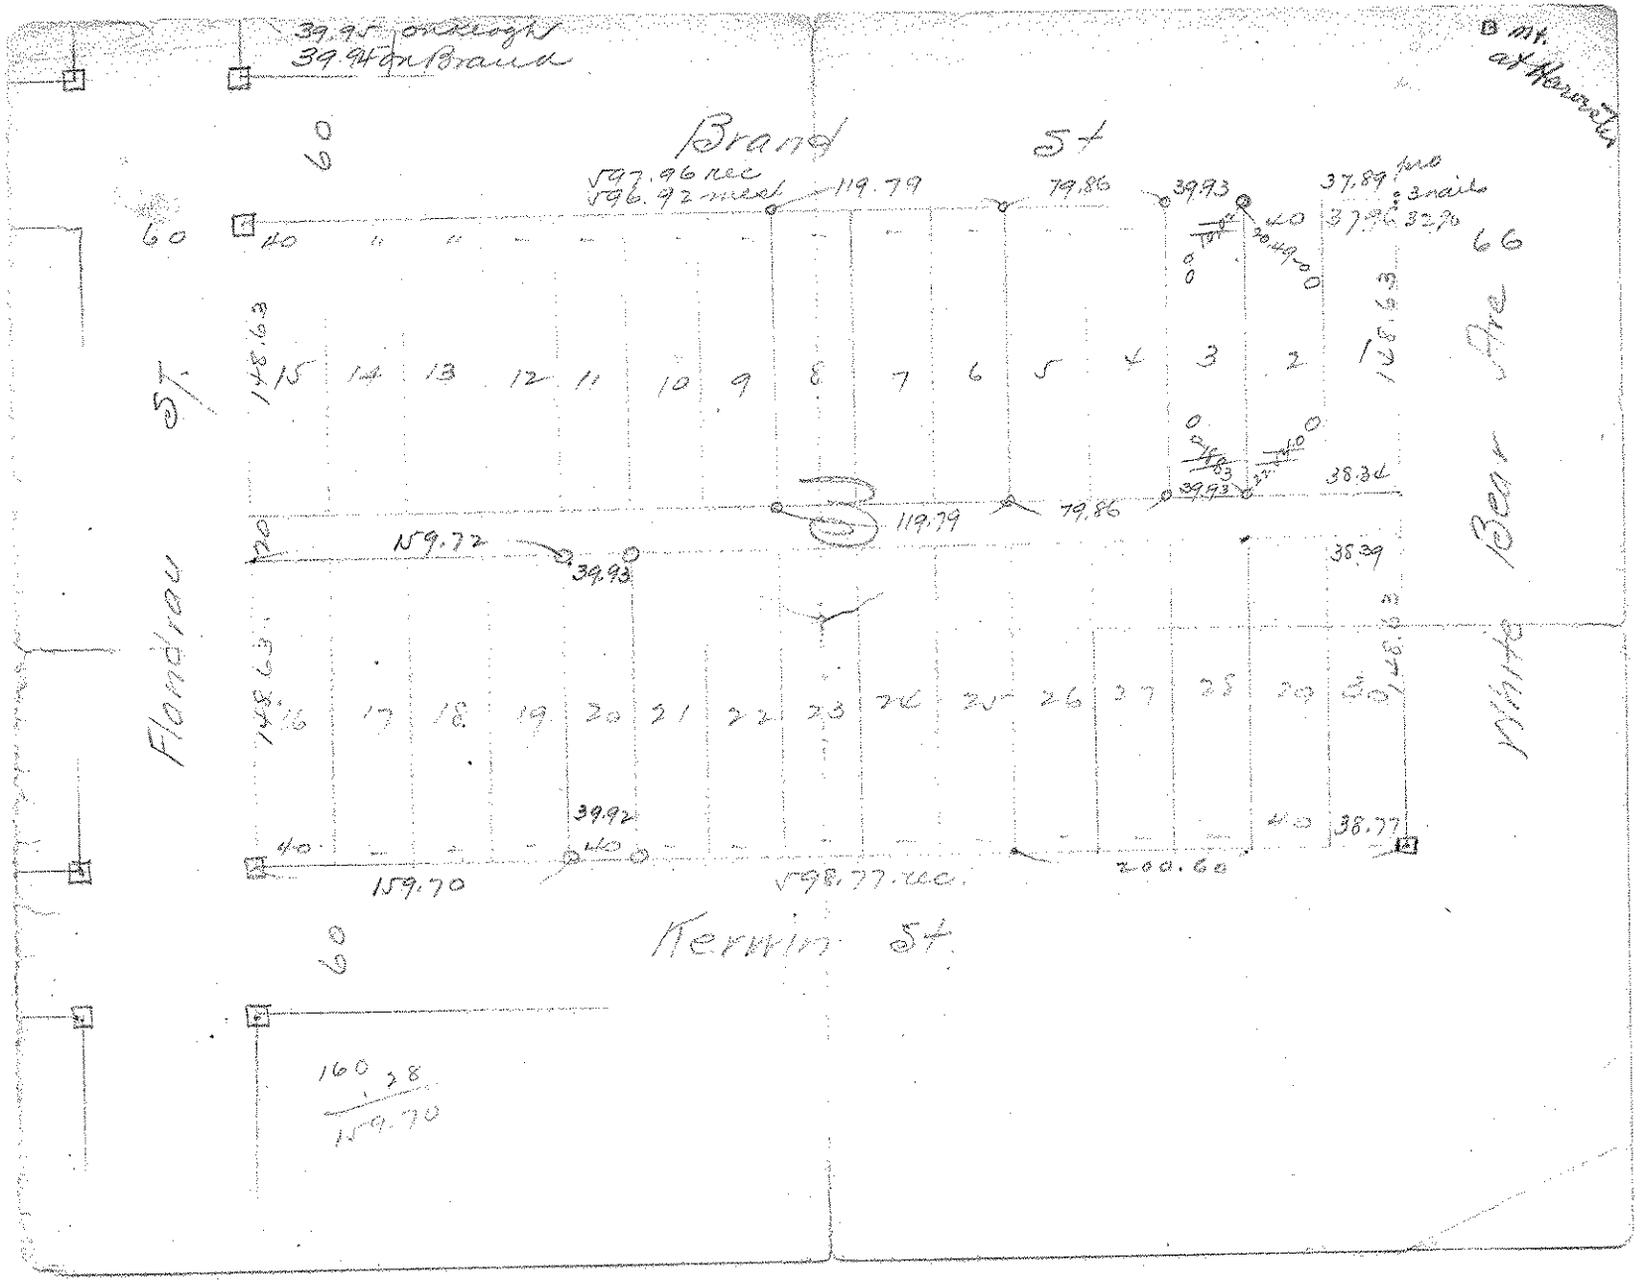
39.95 on Keough
39.94 on Brand
Brand St
97.96 rec
96.92 meas
119.79
79.86
39.93
37.89 rec
3 nails
37.96
32.70
148.63
15 14 13 12 11 10 9 8 7 6 5 4 3 2 1
38.36
38.39
159.72
39.93
Flandrau St
16 17 18 19 20 21 22 23 24 25 26 27 28 29 30
39.92
159.70
98.77 rec.
200.60
38.77
Kerwin St
Bear Ave
160.38
159.70