


120.45
 119.58
 33
 69

28
 1520

237.50
 FLANDRAU

SURVEY OF LOTS 19-20 BLK 4
 BIRMINGHAM PHARR AVE
 FEB 20-1906
 Survey of Oct 7-9 1904
 March 4 to 1918

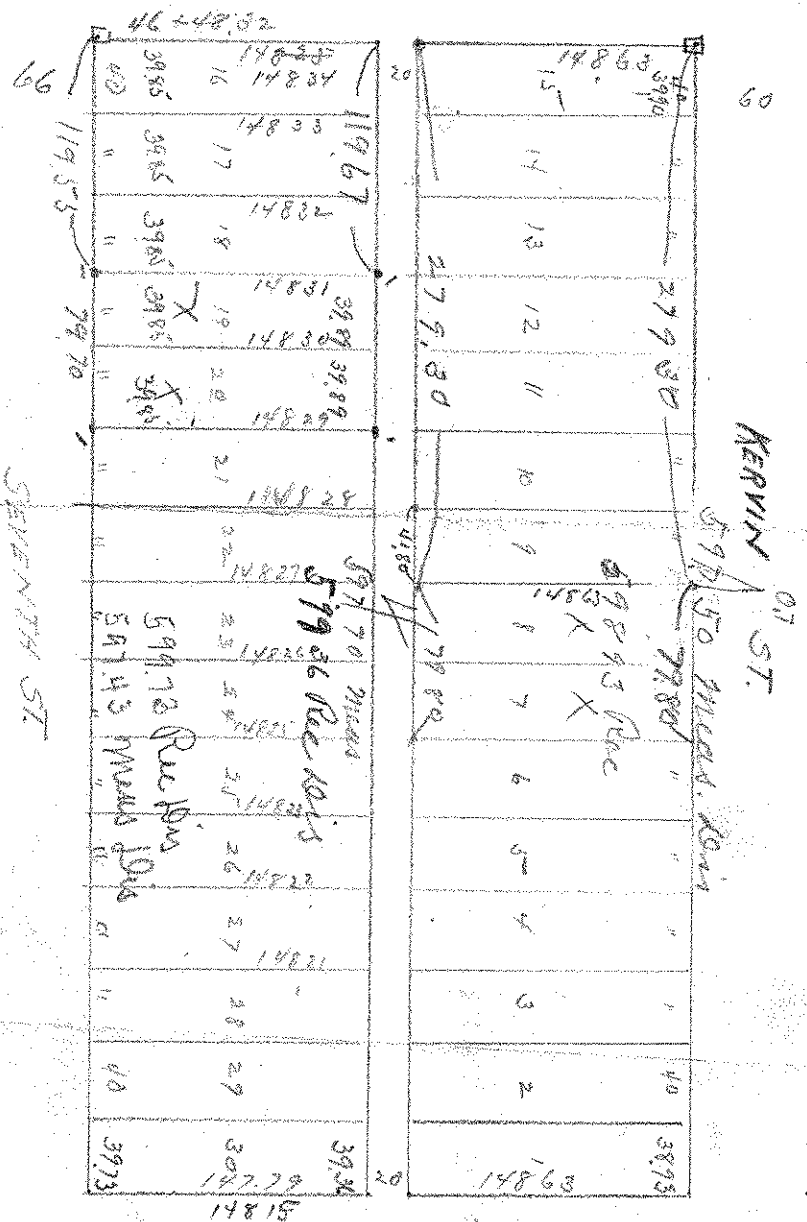

464833
 268188
 8644

527875

597.43

560
 773
 377.73

600
 2300
 1800
 5000
 4800
 20.00

038
 527875
 464833
 63048
 33
 597.43

WHITE BEAR AVE