

FROM THE OFFICE OF

CHARLES O. GEORGI COMPANY

2215 West County Road B

Saint Paul, Minnesota 55113

REGISTERED CIVIL ENGINEER AND LAND SURVEYOR

Certificate of Survey

I Hereby Certify that this plat shows a survey made by me of the property described on this plat, and that the corners are correctly placed as shown, and that all locations have been correctly shown.

Surveyed For *DeLisle Realty*


Date *June, 1970*

Scale *1"=40'*

By *Charles O. Georgi*
REGISTERED LAND SURVEYOR

Description:

Lot 6 and the adjoining Easterly $\frac{1}{2}$
of the vacated alley,
Block 3,
Manton Park,
Ramsey County, Minnesota

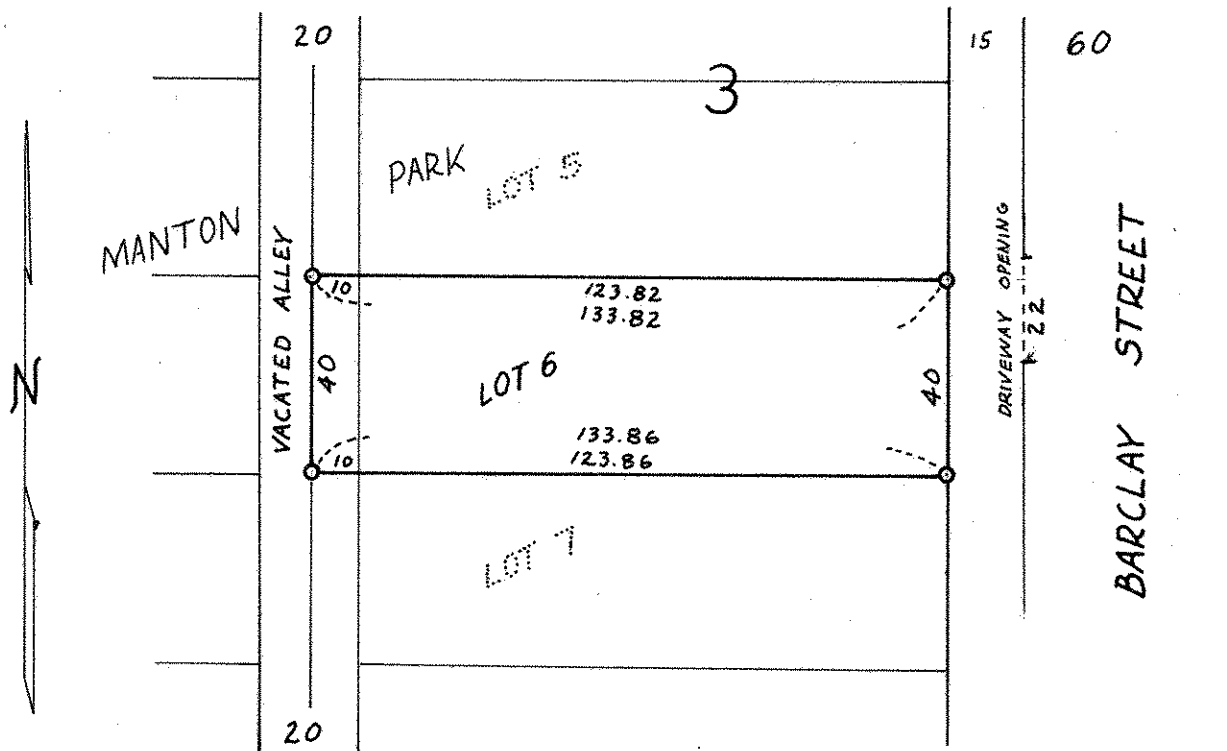

o Denotes Iron Monument