NE 11,29,22

FROM THE OFFICE OF

CHARLES O. GEORGI COMPANY

2215 West County Road B — Saint Paul, Minnesota 55113

REGISTERED CIVIL ENGINEER AND LAND SURVEYOR

Certificate of Survey

I Hereby Certify that **this plat shows a survey made by me of the property described on this plat, and that the corners are correctly placed as shown, and that all locations have been correctly shown.**

Owner: Anna Naomi Blumel

Surveyed For Ed Donlan

Date July 1976

Scale 1" = 60'

By Charles O. Georgi
REGISTERED LAND SURVEYOR

Description:
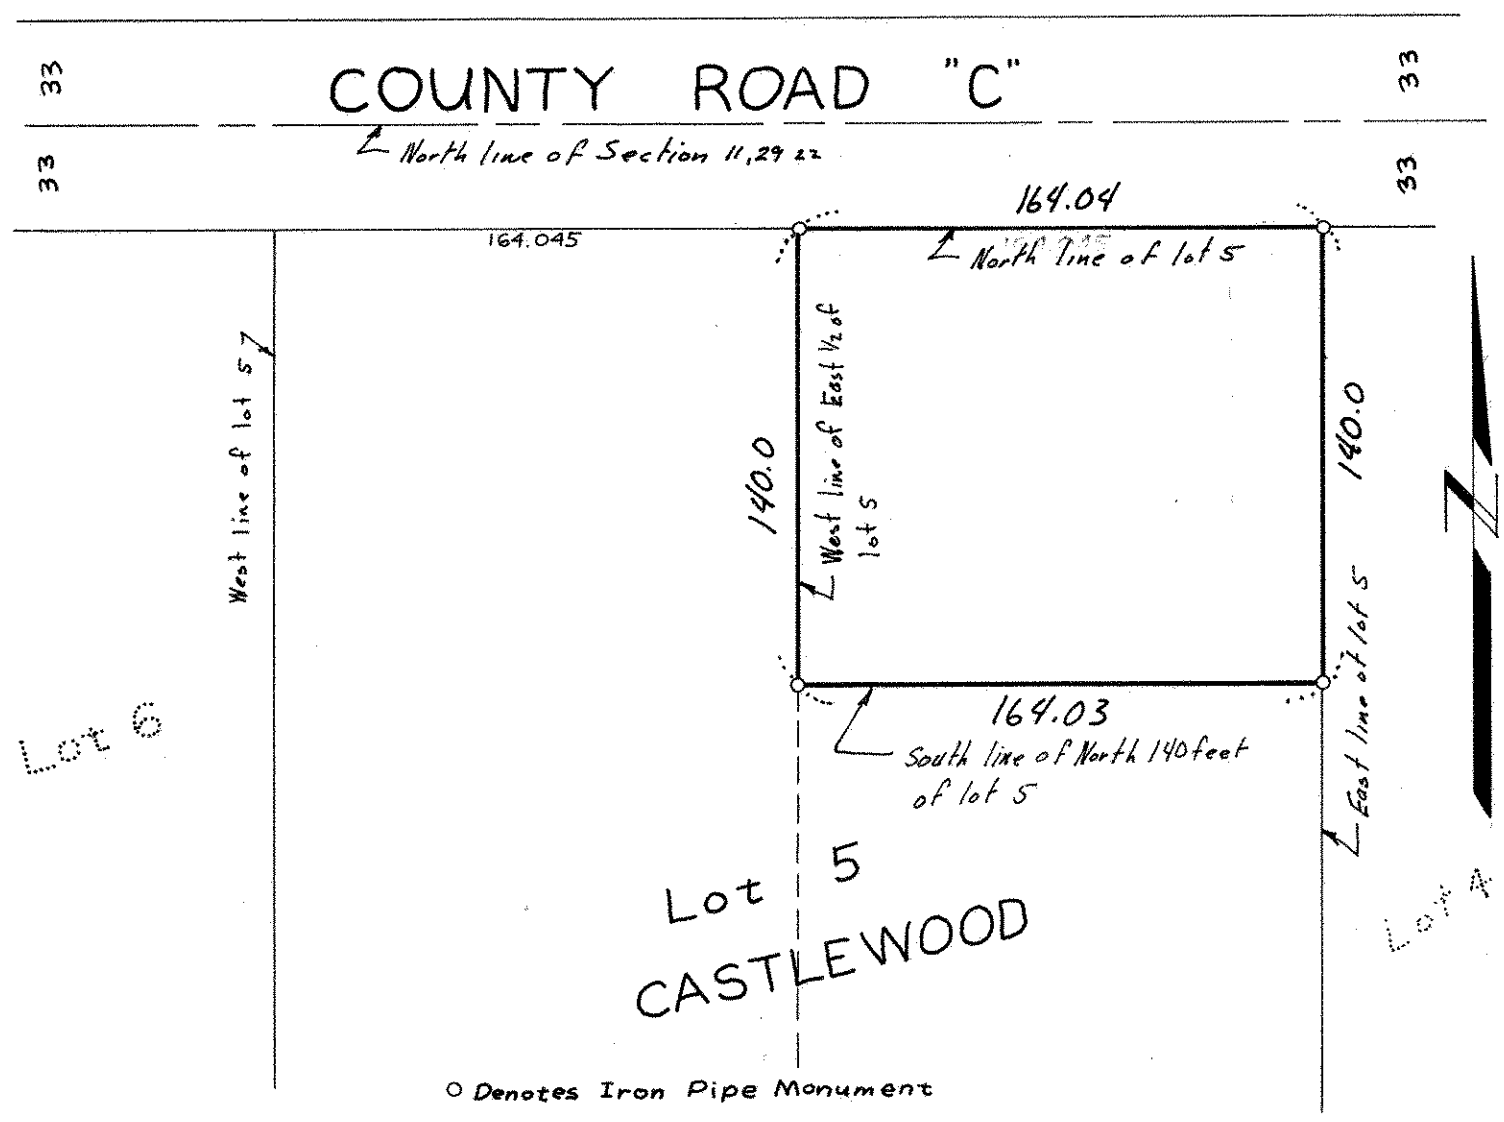
The North 140 feet of the East ½ of Lot 5, Castlewood, Ramsey County, Minnesota