NW 29 29 22

FROM THE OFFICE OF

# CHARLES O. GEORGI COMPANY

2215 West County Road B — Saint Paul, Minnesota 55113

REGISTERED CIVIL ENGINEER AND LAND SURVEYOR

## Certificate of Survey

***I Hereby Certify that*** **this plat shows a survey made by me of the property described on this plat, and that the corners are correctly placed as shown, and that all locations have been correctly shown.**

***Surveyed For*** Richard E. Carroll

***Date*** May 1975

***Scale*** 1" = 20'

By Donald W. Schmidt
REGISTERED LAND SURVEYOR
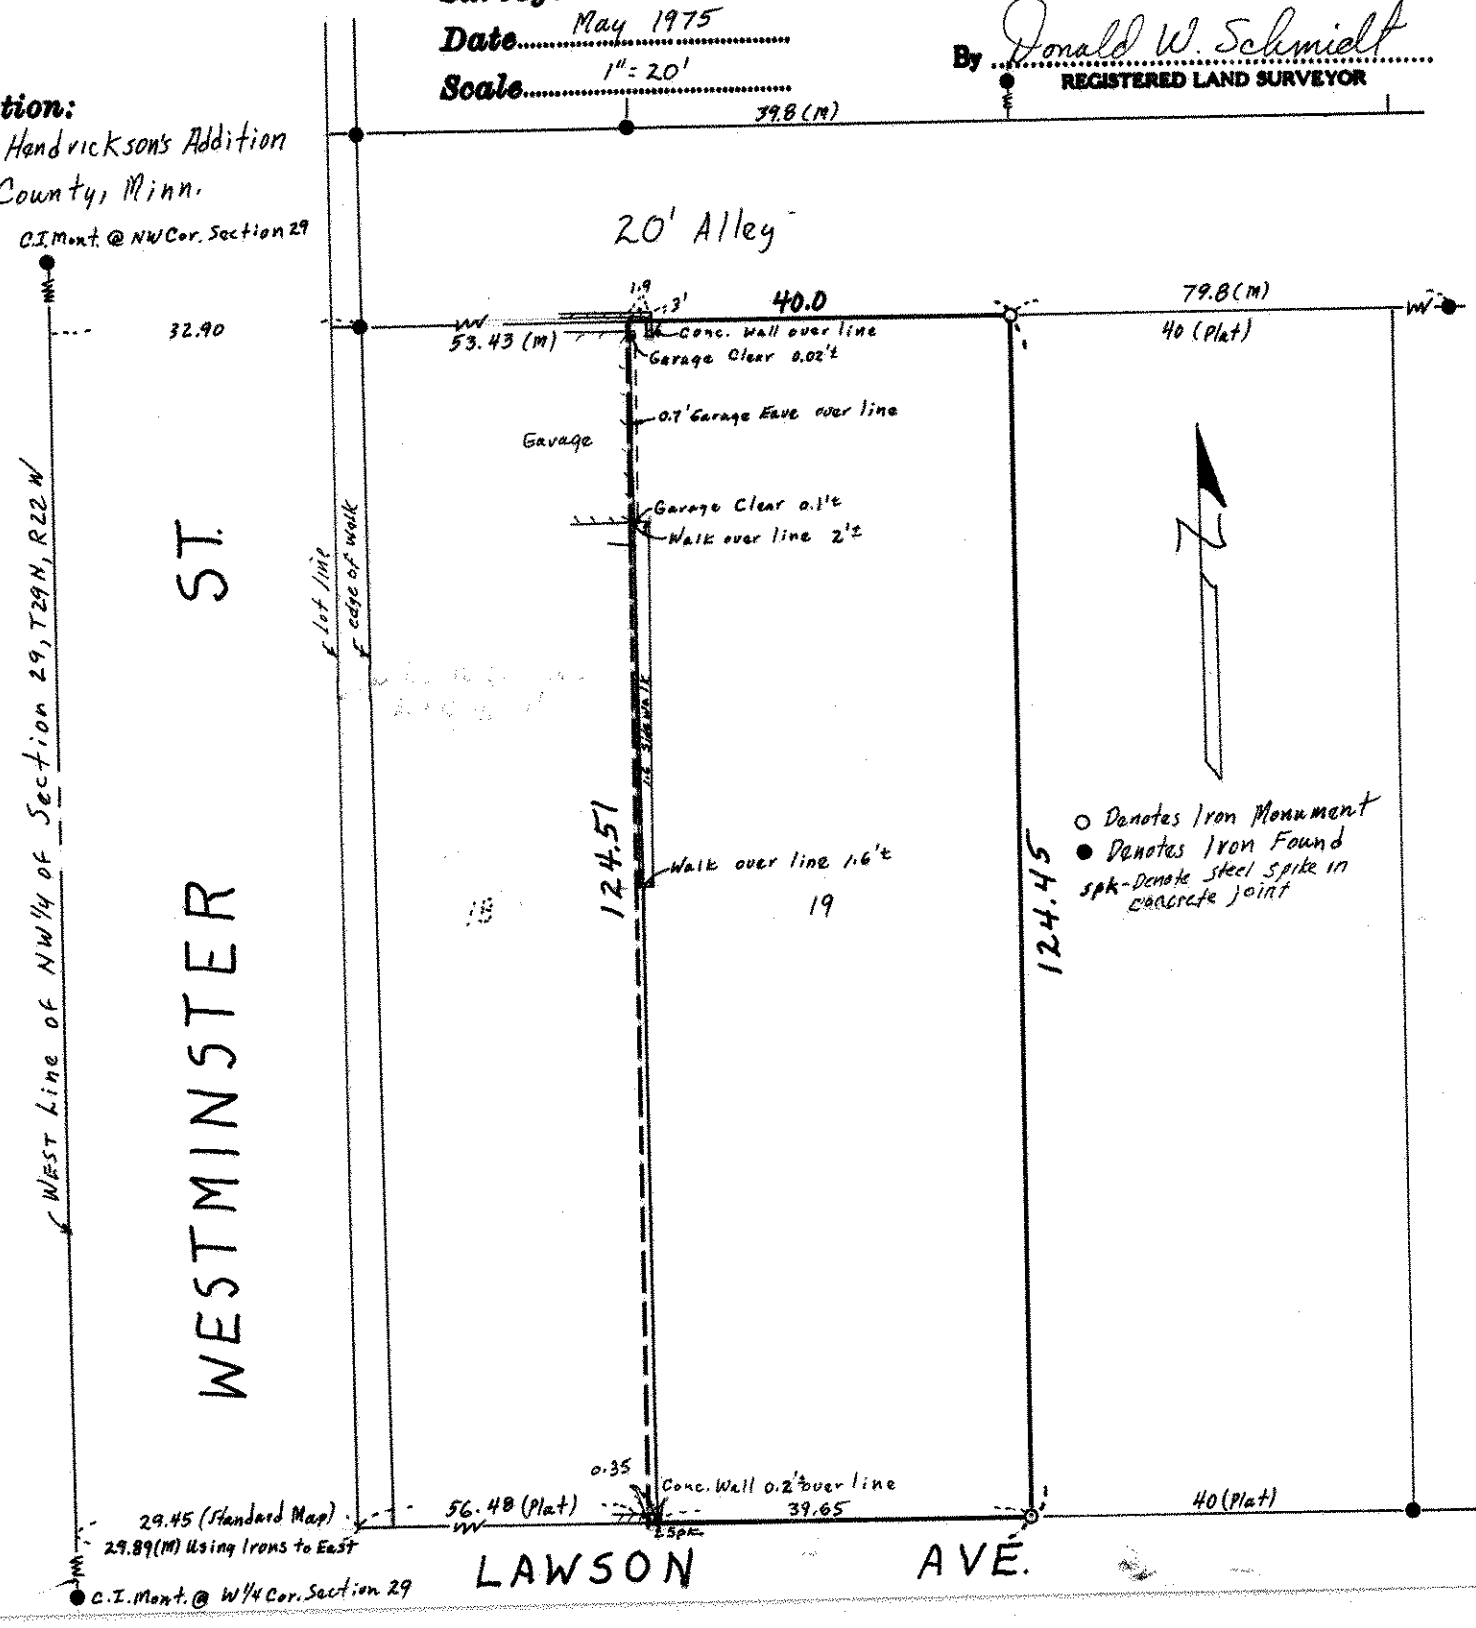
***Description:***
Lot 19, Hendrickson's Addition
Ramsey County, Minn.