NE 14 29 22

FROM THE OFFICE OF

CHARLES O. GEORGI COMPANY

2215 West County Road B Saint Paul, Minnesota 55113

REGISTERED CIVIL ENGINEER AND LAND SURVEYOR

Certificate of Survey

I Hereby Certify that this plat shows a survey made by me of the property described on this plat, and that the corners are correctly placed as shown, and that all locations have been correctly shown.

Surveyed For Joe Cheasick

Date November 1970

Scale 1" = 100'

By Charles O. Georgi
REGISTERED LAND SURVEYOR

Description:
The West 178.65 feet of the North 2 acres of West 4 acres of North 1/2 of South 1/2 of SE 1/4 of NE 1/4 of Section 14, T29N, R22W, except that part thereof taken for Sixth St.
Ramsey County, Minnesota

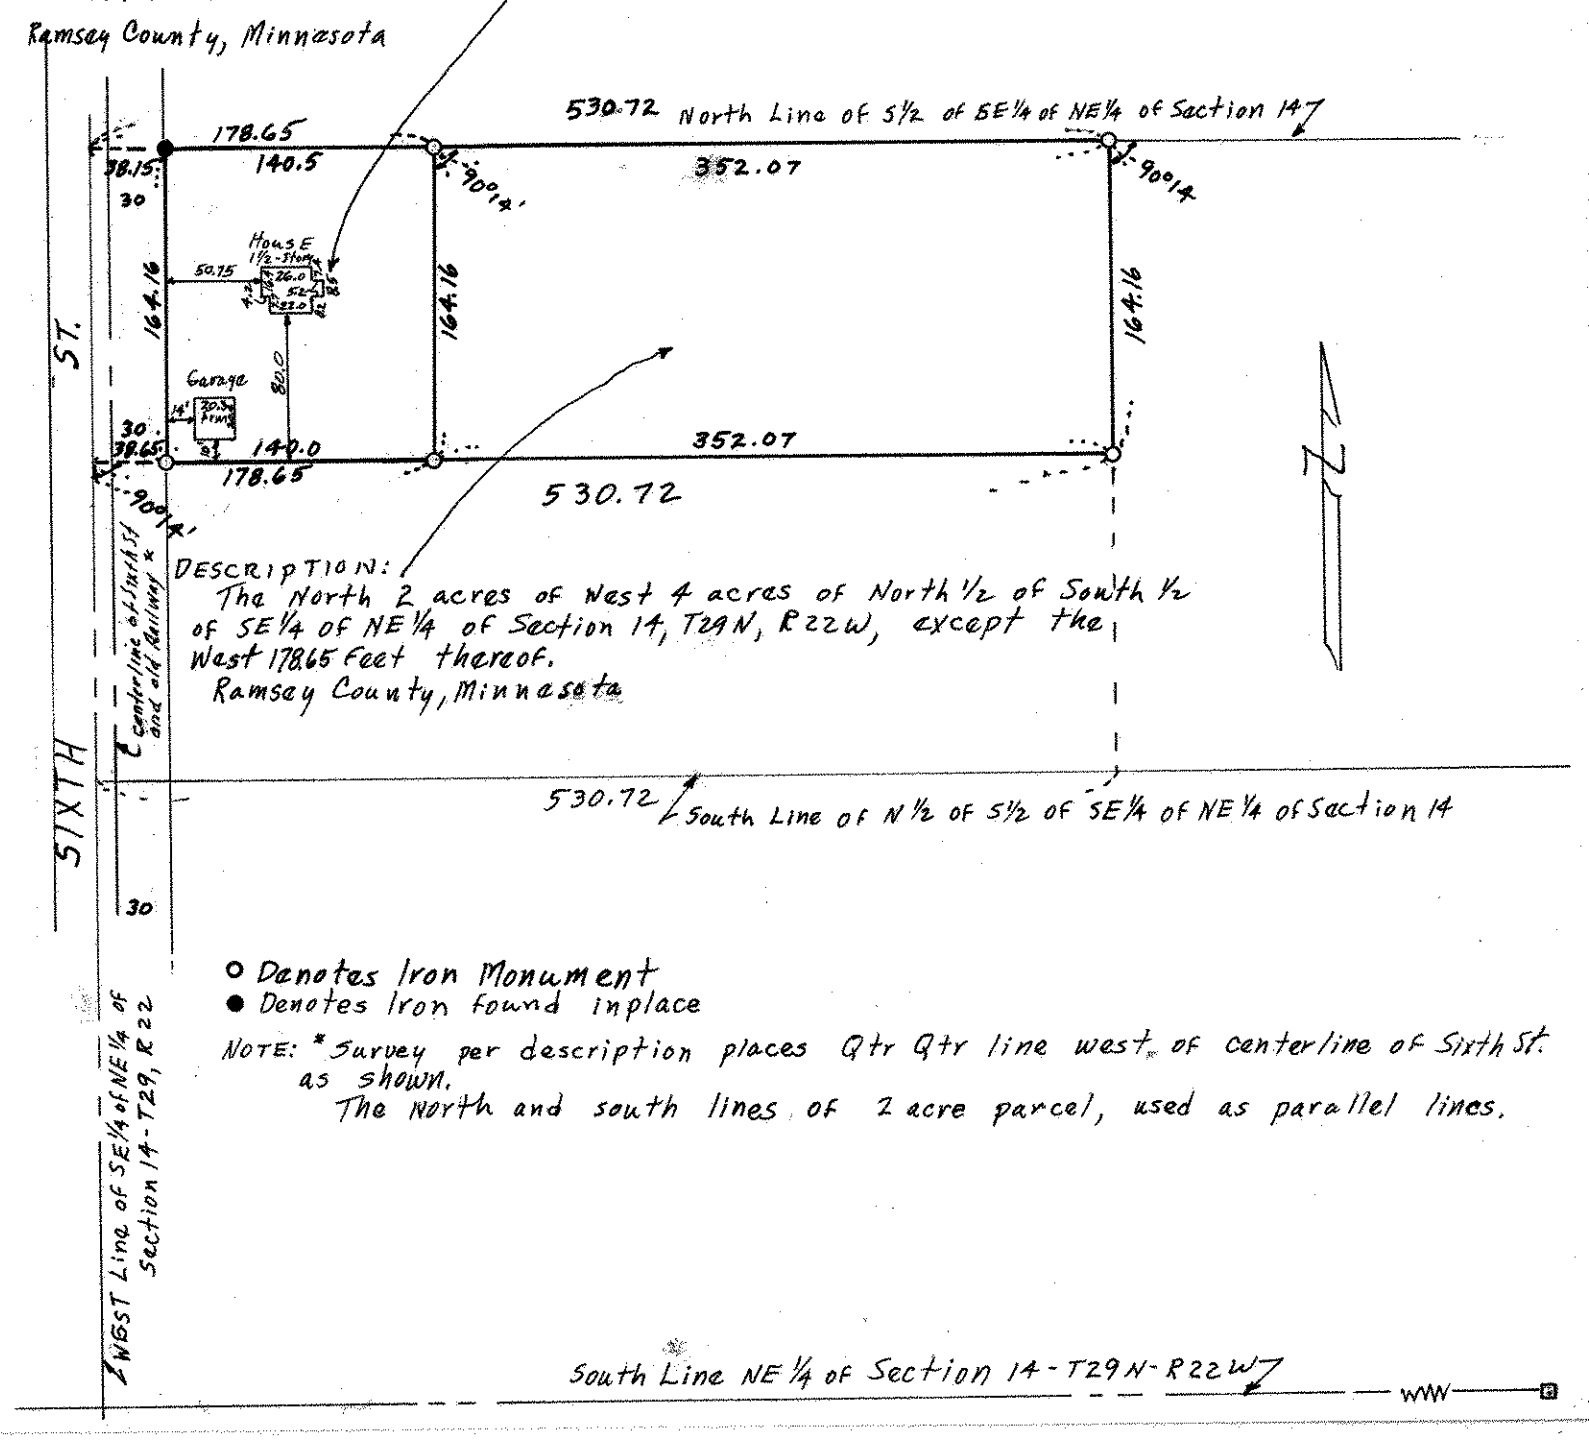

○ Denotes Iron Monument
● Denotes Iron found inplace

NOTE: *Survey per description places Qtr Qtr line west of centerline of Sixth St. as shown.
The North and south lines of 2 acre parcel, used as parallel lines.