Certificate of Survey From the office of

GEORGI- SCHMIDT & ASSOC. INC.

3092 No. Lexington Ave., Roseville, Mn. 55113 LAND SURVEYING

483-4408

I Hereby Certify that this plat shows a survey made by me of the property described on this plat, and that the corners are correctly placed as shown, and that all locations have been correctly shown.

Surveyed For Joseph Chickett

Date May 30 1984

Scale __1" = 40'


REGISTERED LAND SURVEYOR

Description:

Job Number:

Lot 1, Block 4,

Willard Linder Addition No. 2,

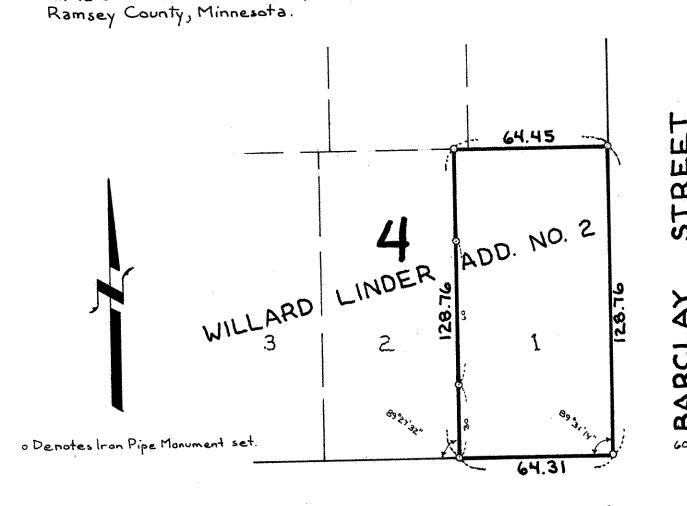

STREET CONWAY