SW 12 29 22

FROM THE OFFICE OF

CHARLES O. GEORGI COMPANY

2215 West County Road B Saint Paul, Minnesota 55113

REGISTERED CIVIL ENGINEER AND LAND SURVEYOR

Certificate of Survey

I Hereby Certify that this plat shows a survey made by me of the property described on this plat, and that the corners are correctly placed as shown, and that all locations have been correctly shown. *

Surveyed For Pat Christenson

Date March 1978

Scale 1" = 40'

By Charles O. Georgi
REGISTERED LAND SURVEYOR

Description:

Lot 17, Block 8, 1st Addition to North St. Paul

Ramsey County, Minnesota
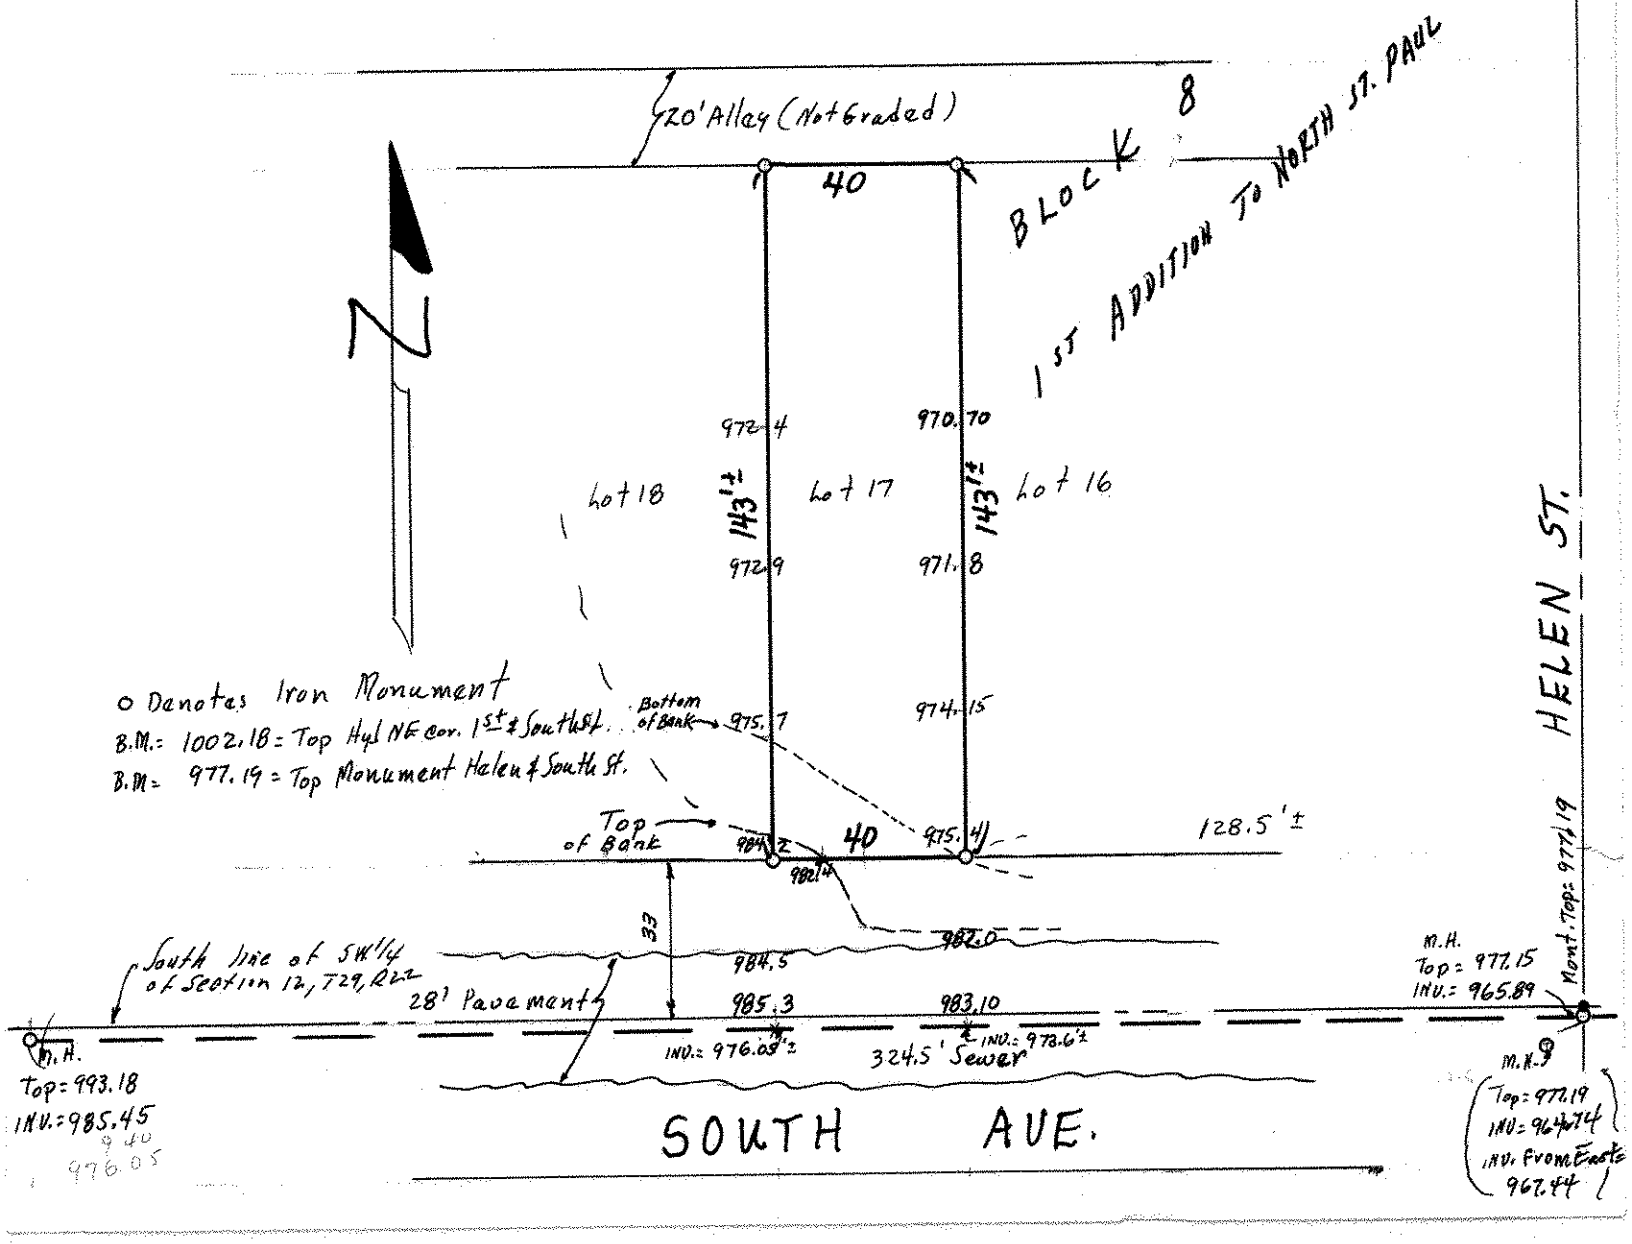
* Survey in accordance with control from irons found in place in this Block and adjoining Blocks and the Section line which agree within 0.5 feet East and West.