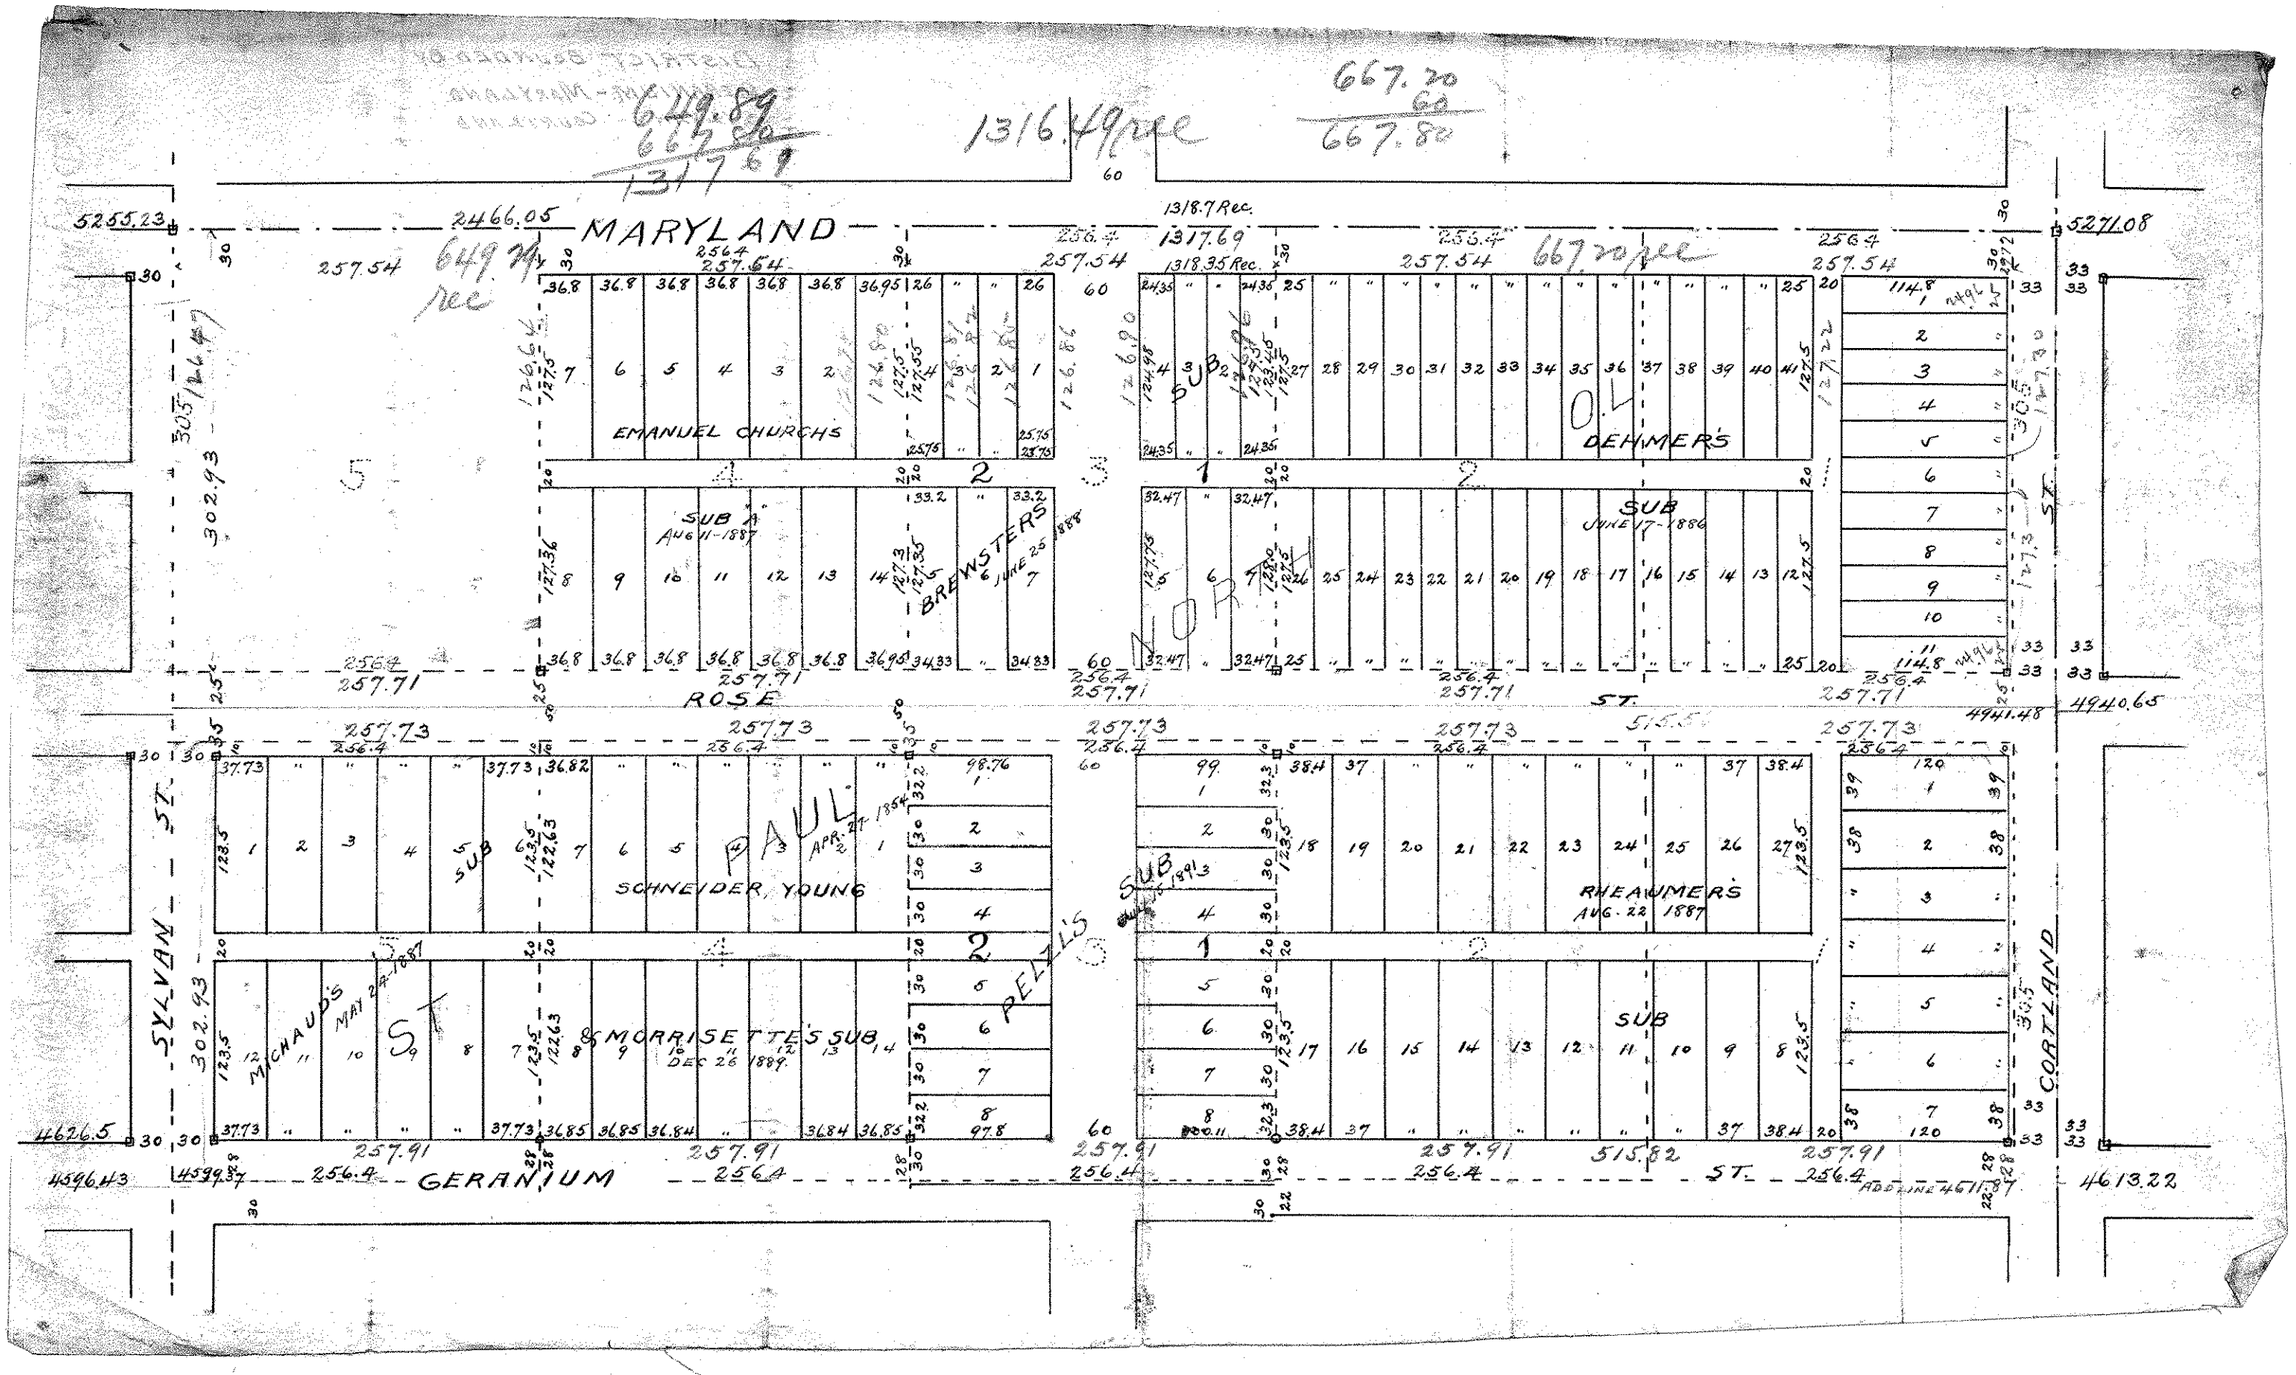

MARYLAND
ROSE ST.
GERANIUM ST.
SYLVAN ST.
CORTLAND ST.
EMANUEL CHURCHS
SUB "A" AUG 11-1887
BREWSTERS JUNE 25 1888
DEHMER'S
SUB JUNE 17-1886
SCHNEIDER, YOUNG
PAUL APR. 27 1854
MICHAUD'S MAY 24-1887
MORRISETTE'S SUB DEC 26 1889
PELZL'S SUB
RHEAUMER'S AUG. 22 1887
SUB
NORTH
O.L.
1318.7 Rec.
1318.35 Rec.
1316.49 rec
649.89
667.20
1317.69
667.80
5255.23
2466.05
5271.08
4941.48
4940.65
4626.5
4596.43
4599.37
4613.22
ADD LINE 4611.87