SE 3 29 22

FROM THE OFFICE OF

CHARLES O. GEORGI COMPANY

2215 West County Road B Saint Paul, Minnesota 55113

REGISTERED CIVIL ENGINEER AND LAND SURVEYOR

Certificate of Survey

I Hereby Certify that this plat shows a survey made by me of the property described on this plat, and that the corners are correctly placed as shown, and that all locations have been correctly shown.

Surveyed For Charles Hoppe

Date April 1976

Scale 1" = 40

By [signature]
REGISTERED LAND SURVEYOR

Description:

The East 100 feet of the West 238 feet of the South 178 feet of the SE¼ of SE¼ of Section 3, T29N, R22W.
Subject to County Road C.
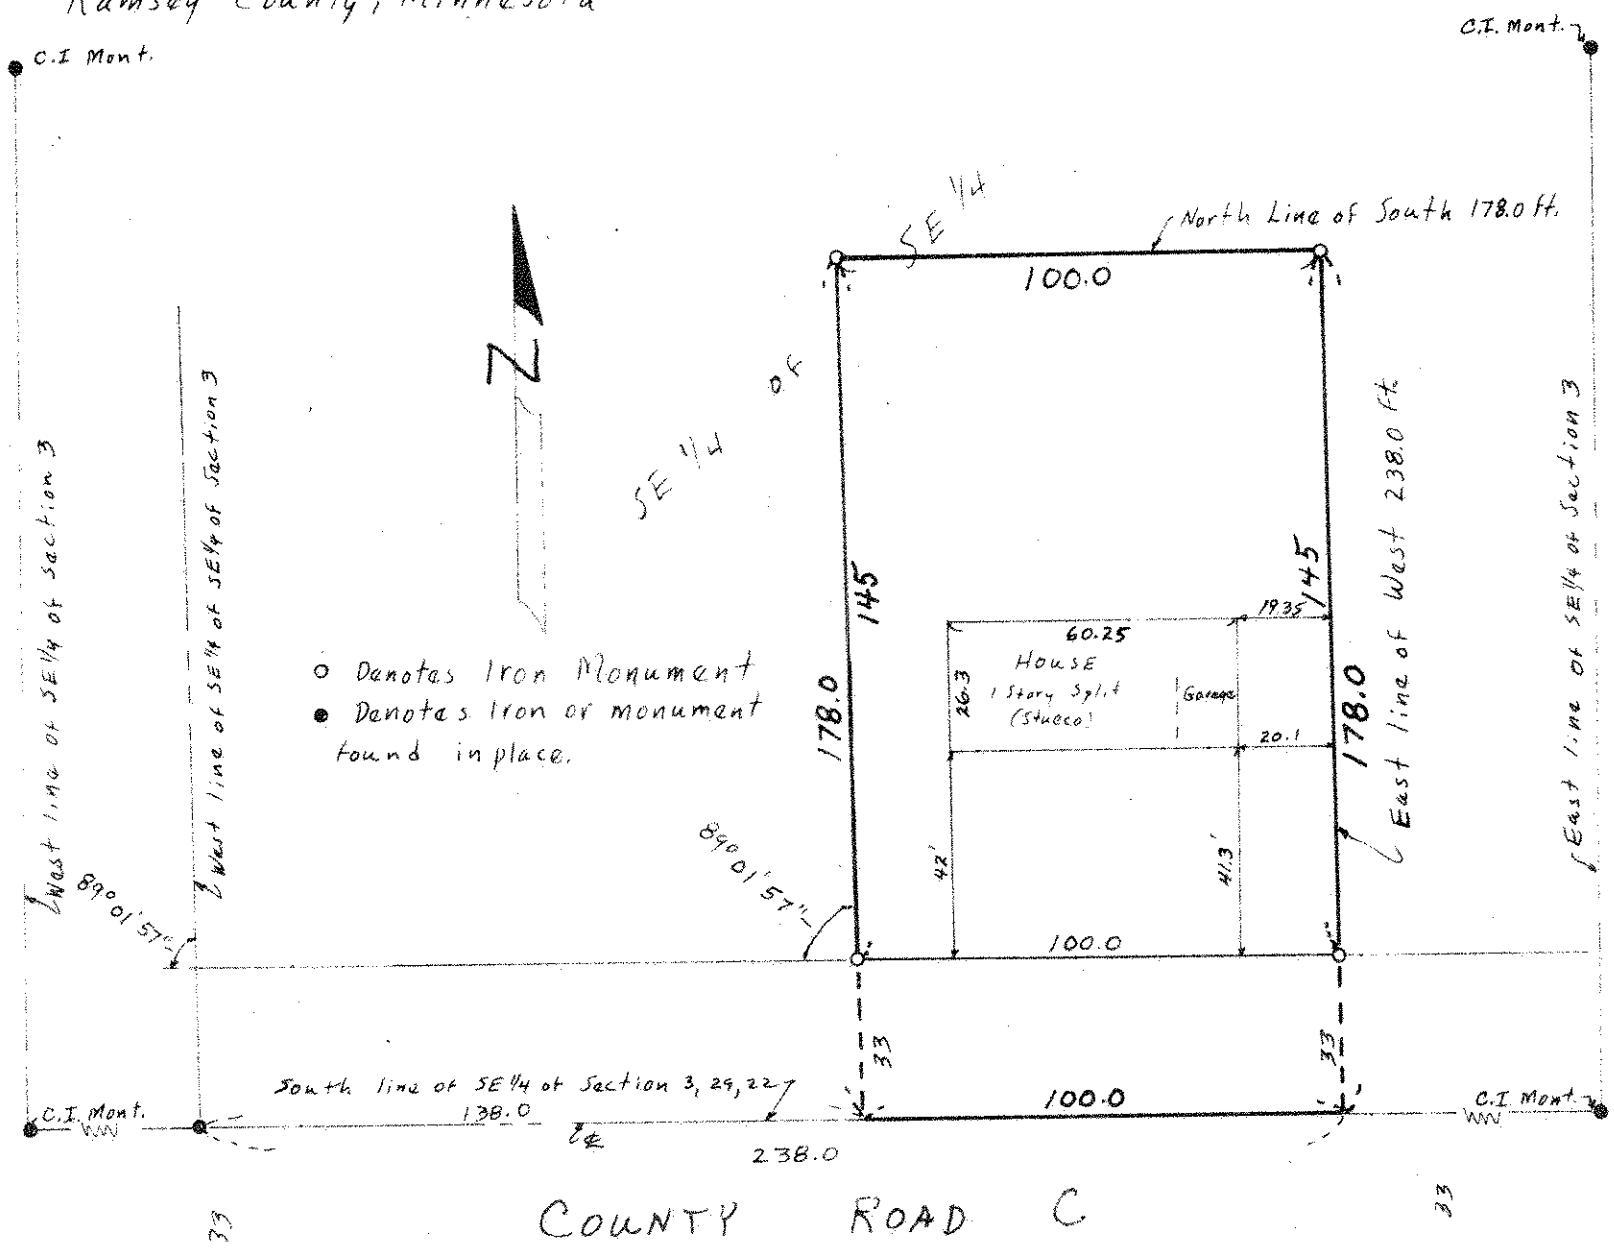
Ramsey County, Minnesota