(2)

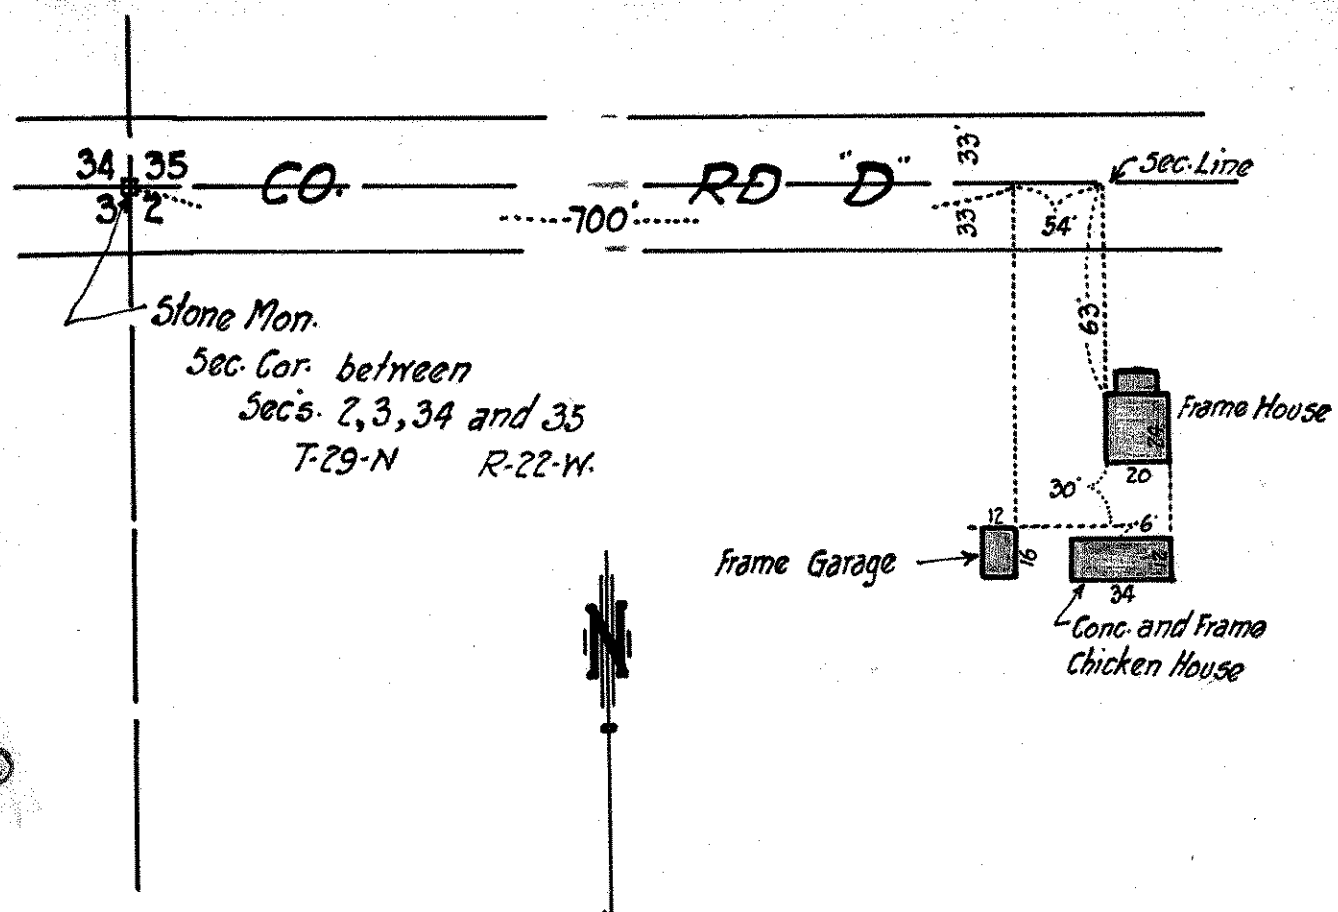

SURVEY FOR THE
SUBURBAN INVESTMENT CO.

Scale-100'=1"

P.R. Banister. Registered Professional
Engineer- Dec-10-1928

Office-69-7th Ave. North St Paul, Minn. Phone-N.S.P. 407
Res- 139-18th " " " " " " " 448

file Sec 2-29-22