

MR. GABERT  
MR. HOFF  
Gentlemen:

By action of North St. Paul Village Council May, 7th, 1928 you are heroby notified  
to remove the structures shown on attached sketch from public property within  
30 days according to the statutes


signed *Franklin* Mayor.

*W. J. Bergstrom* Clerk.

*Mayor M. Wilson* Village Attorney.

**20TH AVE.**

**PARK ROW**

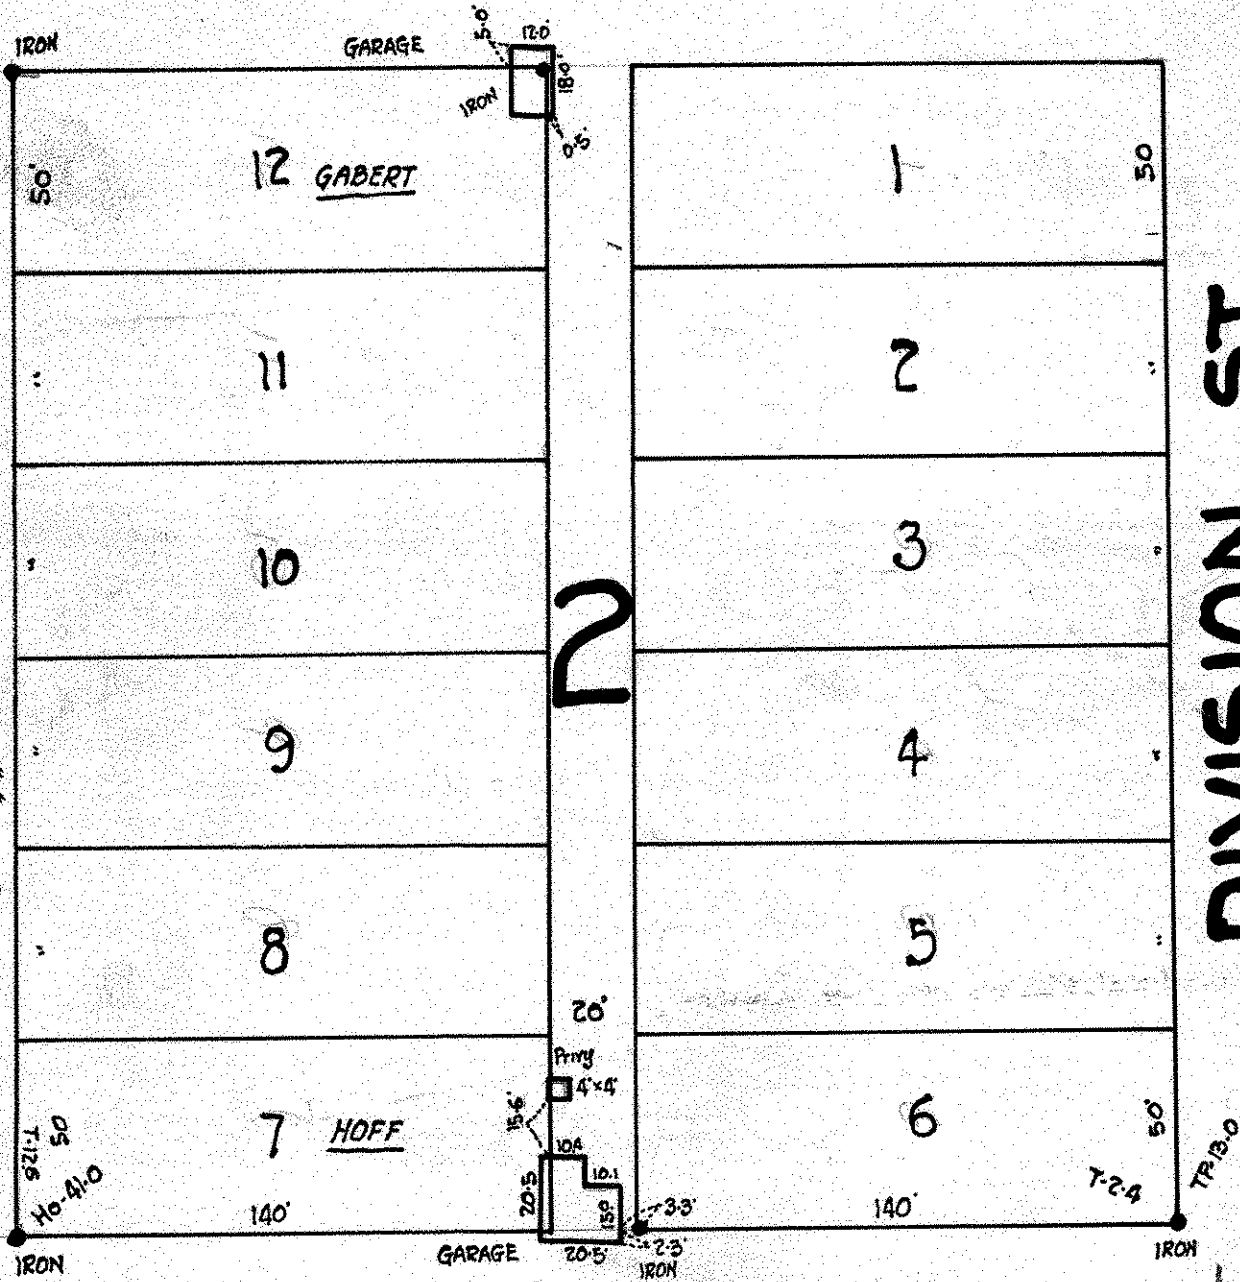

**DIVISION ST.**

**19TH AVE.**

SURVEY - MAY, 4, 1928

SCALE - 50' = 1"

P. R. BANISTER, VILLAGE ENGR.

P. R. BANISTER  
CIVIL ENGR.

35 10 Ave. - St. Paul, Minn.  
PHONE - N. ST. P. 35

*Recd - 29-22*