

SW 12, 29, 22

FROM THE OFFICE OF

CHARLES O. GEORGI COMPANY

2215 West County Road B

Saint Paul 13, Minnesota

REGISTERED CIVIL ENGINEER AND LAND SURVEYOR

Certificate of Survey

I Hereby Certify that this plat shows a survey made by me of the property described on this plat, and that the corners are correctly placed as shown, and that all locations have been correctly shown.

Surveyed For Dennis C. Lythe

Date Oct 63

Scale 1" = 50'

Description:


Lot 14

Block 7

First Addition to

North St. Paul

By _____
REGISTERED LAND SURVEYOR

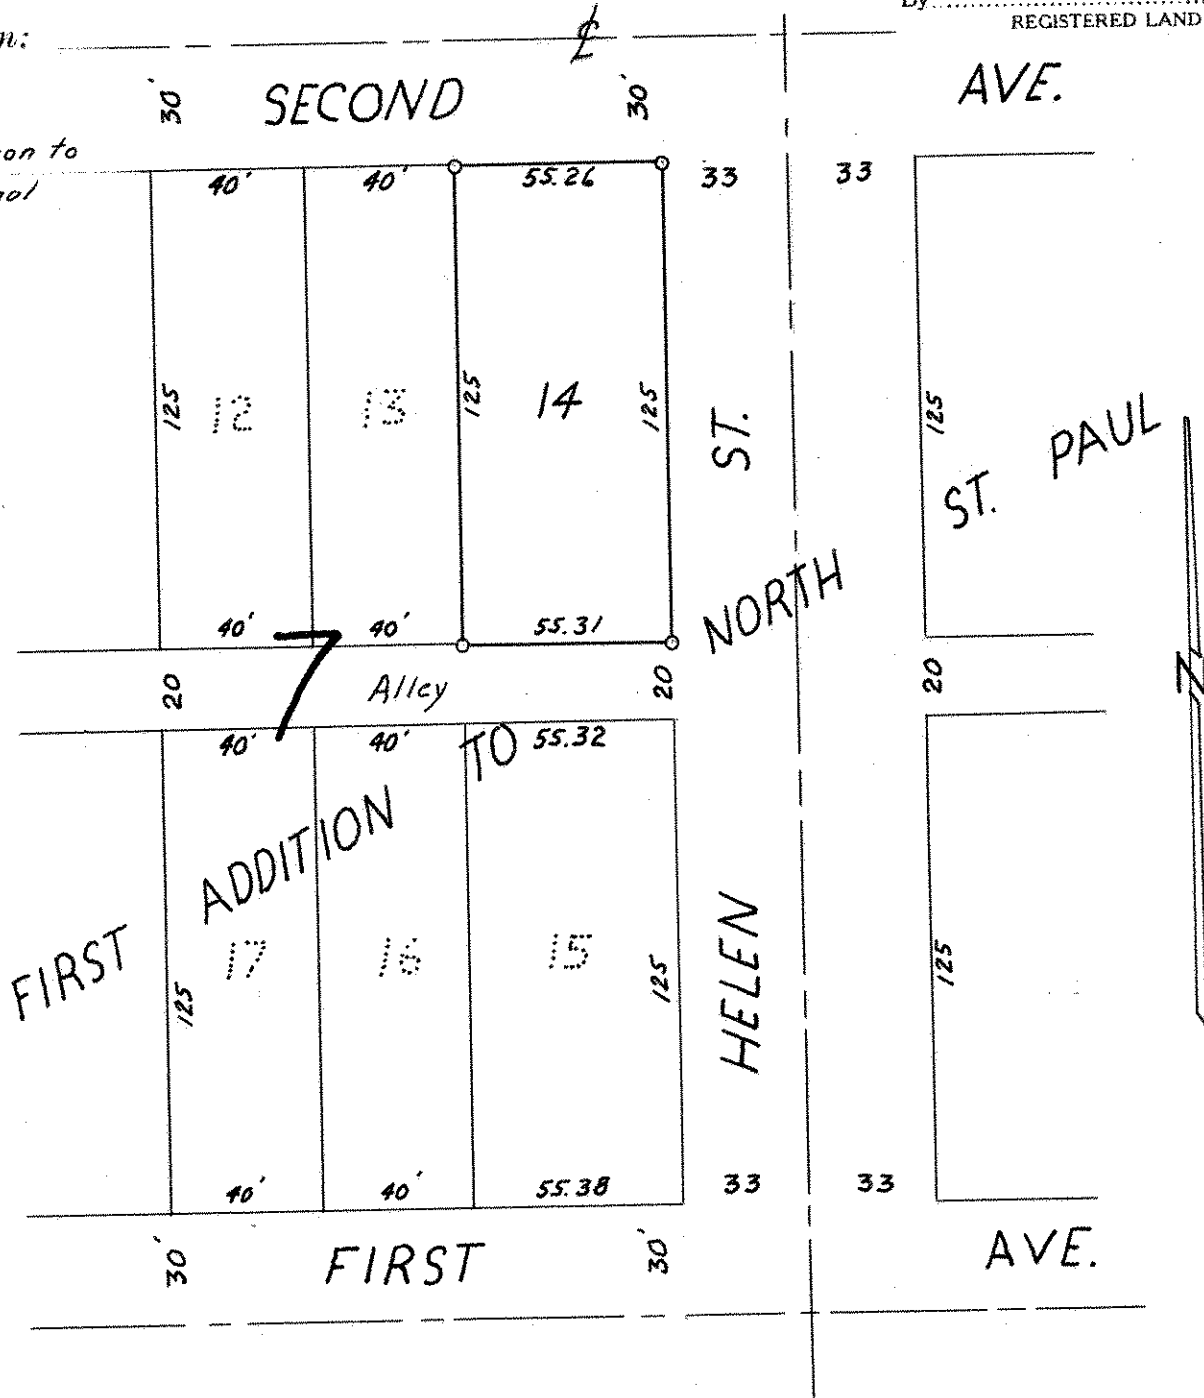

o Denotes Iron Monument