

NE - 7 - 29 - 22

# Certificate of Survey

From the office of  
**GEORGI-SCHMIDT & ASSOC. INC.**  
3092 No. Lexington Ave., Roseville, Mn. 55113  
LAND SURVEYING  
483-4408

I Hereby Certify that this plat shows a survey made by me of the property described on this plat, and that the corners are correctly placed as shown,

Job Number: 1250

Surveyed For Tom LINZMEYER


Date SEPTEMBER 14, 1982

Scale 1" = 50'

By Donald W. Schmidt  
REGISTERED LAND SURVEYOR  
#10459

**Description:**

Lot 1, Block 2, Roy Wilson Addition  
Ramsey County, Minnesota

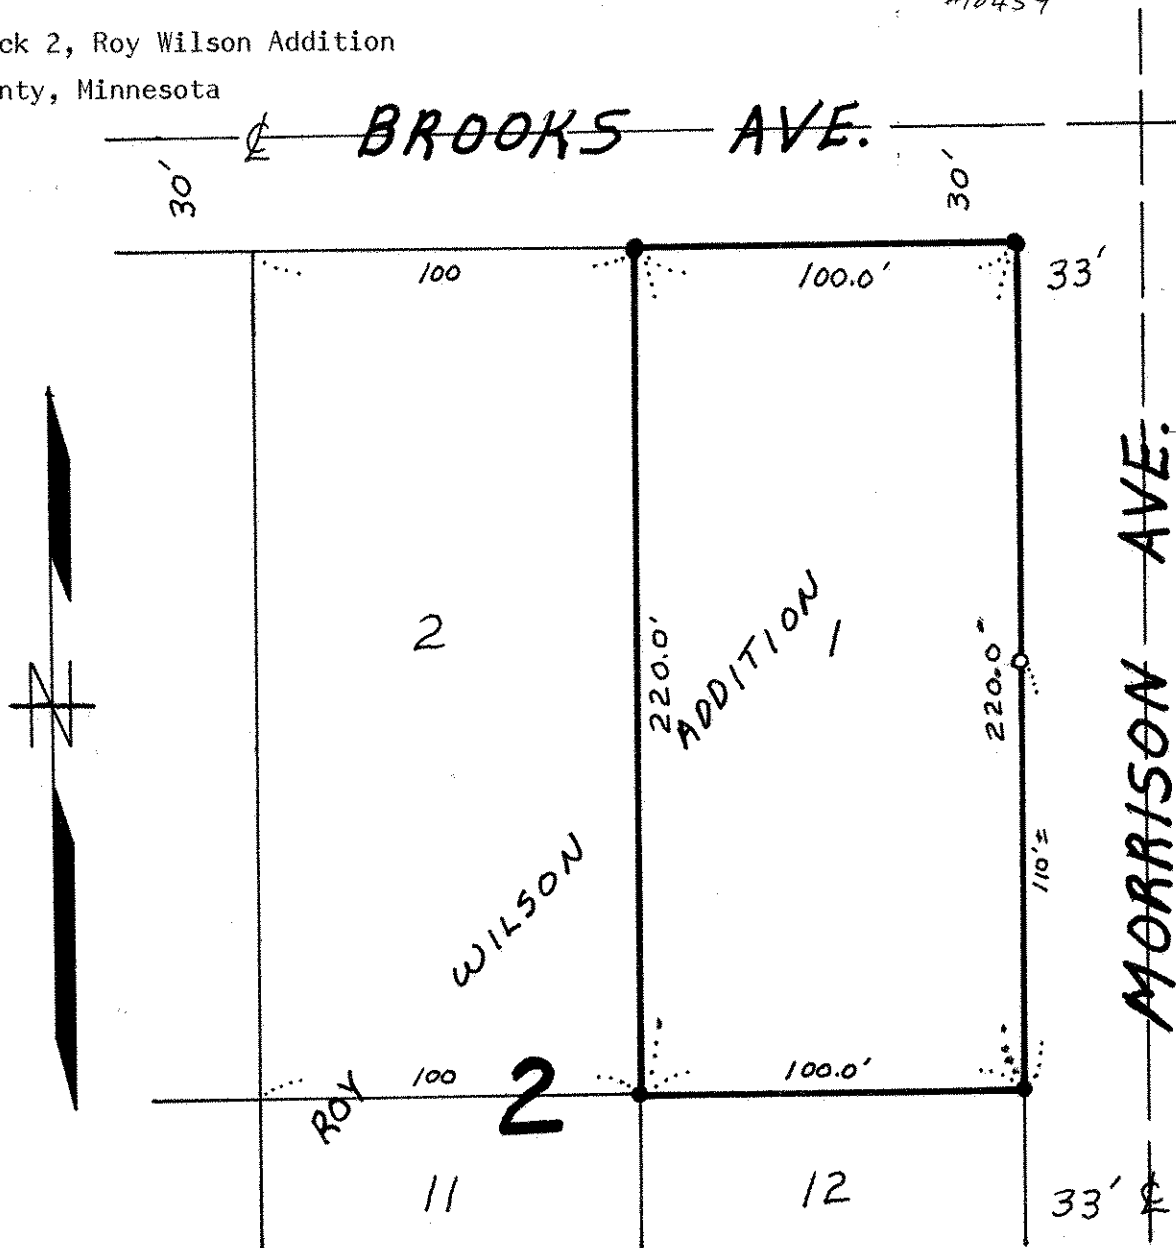

● DENOTES IRON PIPE MONUMENT FOUND  
○ DENOTES IRON PIPE SET