

WARREN I. FORSBERG

2060 E. 5th St.
St. Paul 6, Minn.


Registered Land Surveyor

*Trouble here
to East
Writs*

PLAT OF SURVEY

OF PROPERTY OF

described as follows: Except the East 67.00 feet, the following described property; that part of Lot 1 lying South of a line that is 40.00 feet South of and parallel to the North line of section 19, T 29, R 22, all of Lots 2, 3, 4 and the North 8.55 feet of Lot 5, all in Block 2, Gurney Highland Park, and that part of the East $\frac{1}{2}$ of the vacated alley lying West of and adjacent to said property. St. Paul, Minnesota.

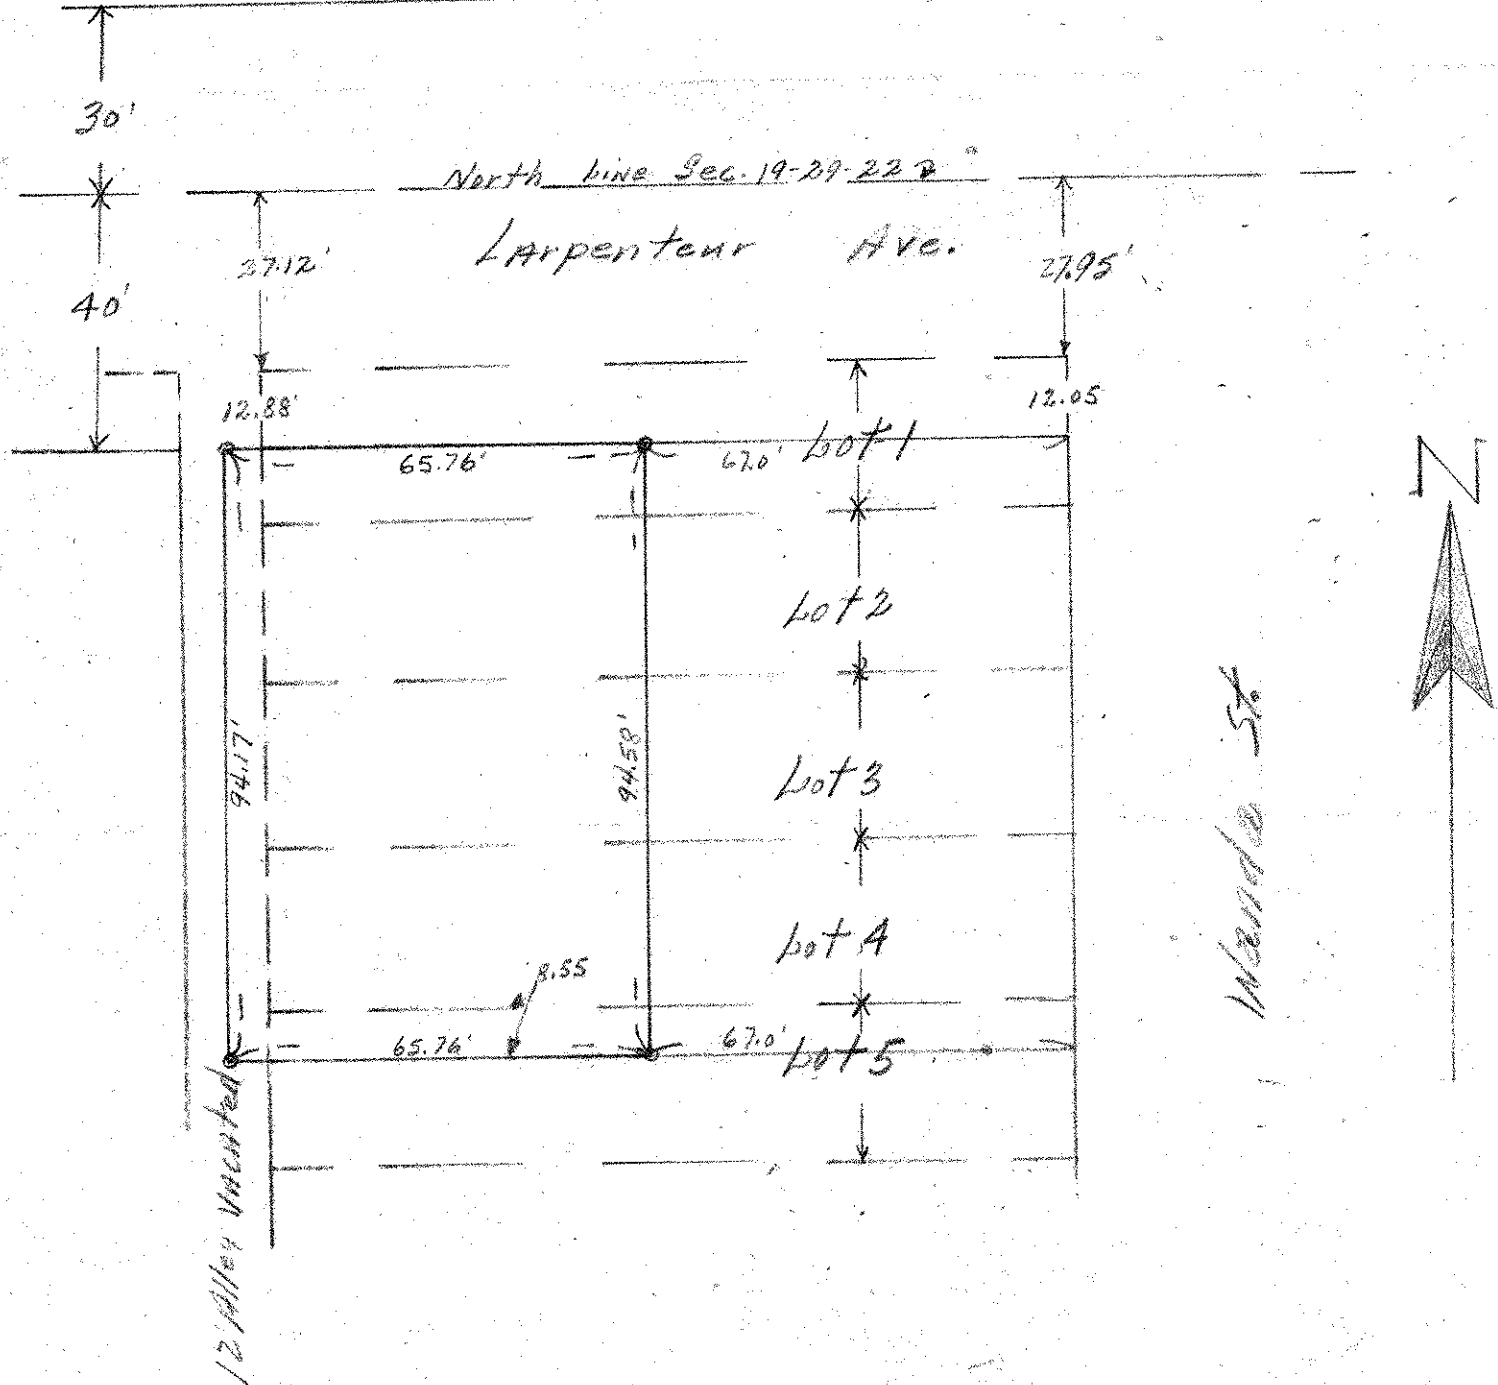

CERTIFICATE OF SURVEY

I hereby certify that on July 7, 1956 I surveyed the property described above and that the above plat is a correct representation of said survey.

Scale: 1 inch 30 feet.
O—Indicates Iron Monument.

OK 177