SE 30 29 22

FROM THE OFFICE OF

CHARLES O. GEORGI COMPANY

2215 West County Road B Saint Paul, Minnesota 55113

REGISTERED CIVIL ENGINEER AND LAND SURVEYOR

Certificate of Survey

I Hereby Certify that this plat shows a survey made by me of the property described on this plat, and that the corners are correctly placed as shown, and that all locations have been correctly shown.

Surveyed For Lois Mondell

Date May 1974

Scale 1" = 40'

By Charles O. Georgi
REGISTERED LAND SURVEYOR

Description:

Lot 17, except the East 11 feet of the North 72 feet, Block 3, Edmund Rice 2nd Addition

Surveyors NOTE:
Shortage and access from Survey of entire Block prorated equally to all lots.
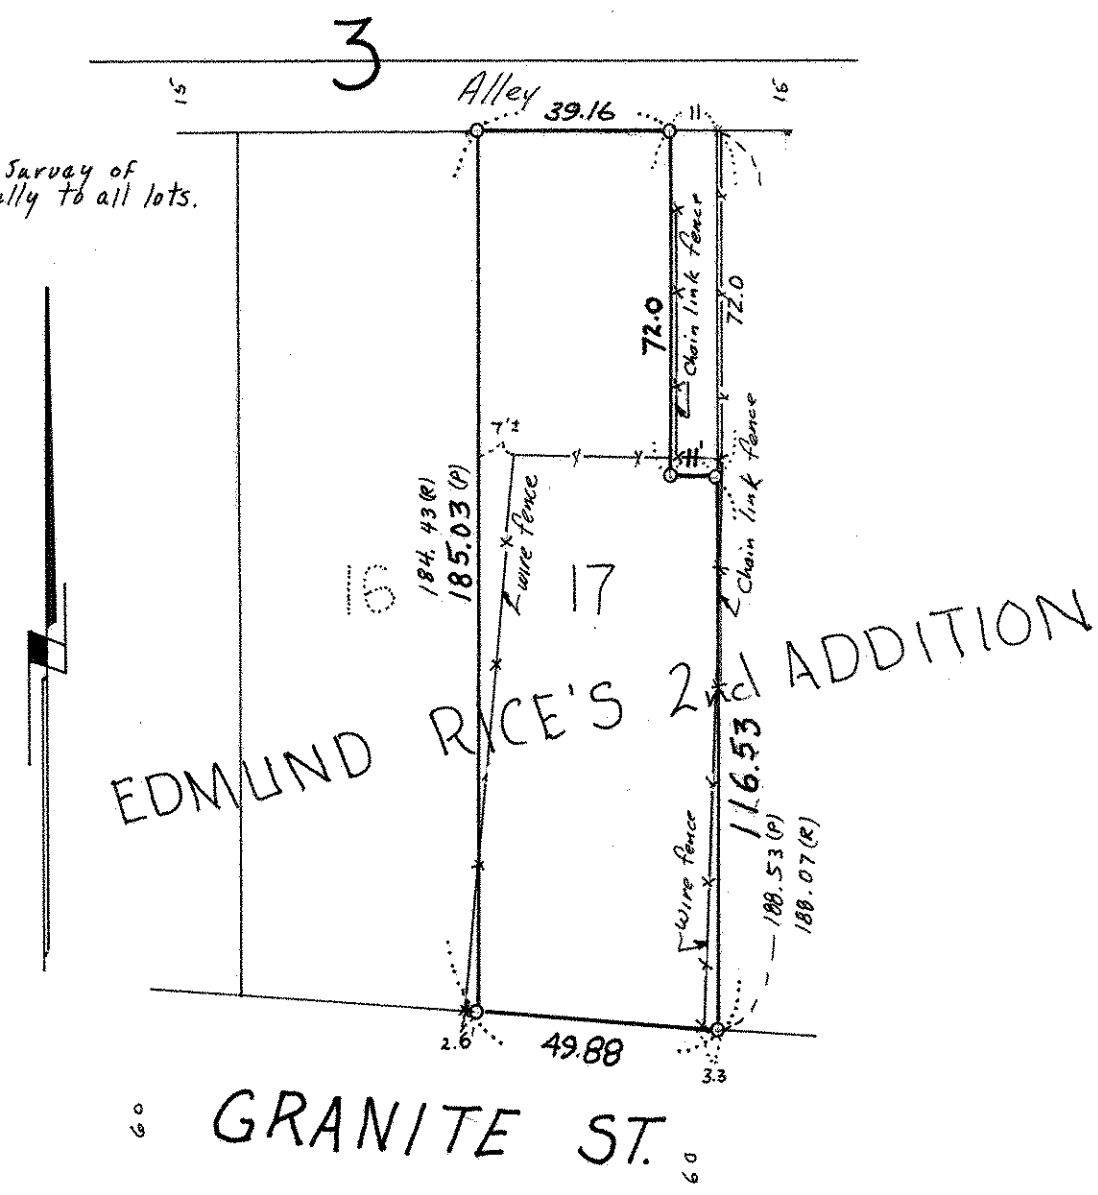
o denotes iron monument.
(R) Denotes Record distance
(P) Denotes Prorated distance