SE 30 29 22

Certificate of Survey

From the office of

GEORGI- SCHMIDT & ASSOC. INC.

3092 No. Lexington Ave., Roseville, Mn. 55113

LAND SURVEYING

483-4408

I Hereby Certify that this plat shows a survey made by me of the property described on this plat, and that the corners are correctly placed as shown, and that all locations have been correctly shown.

Job Number: 747

Surveyed For Frank Mikatowski - Attorney

Date 9/5/80

Scale 1" = 40'

By Donald W. Schmidt
REGISTERED LAND SURVEYOR
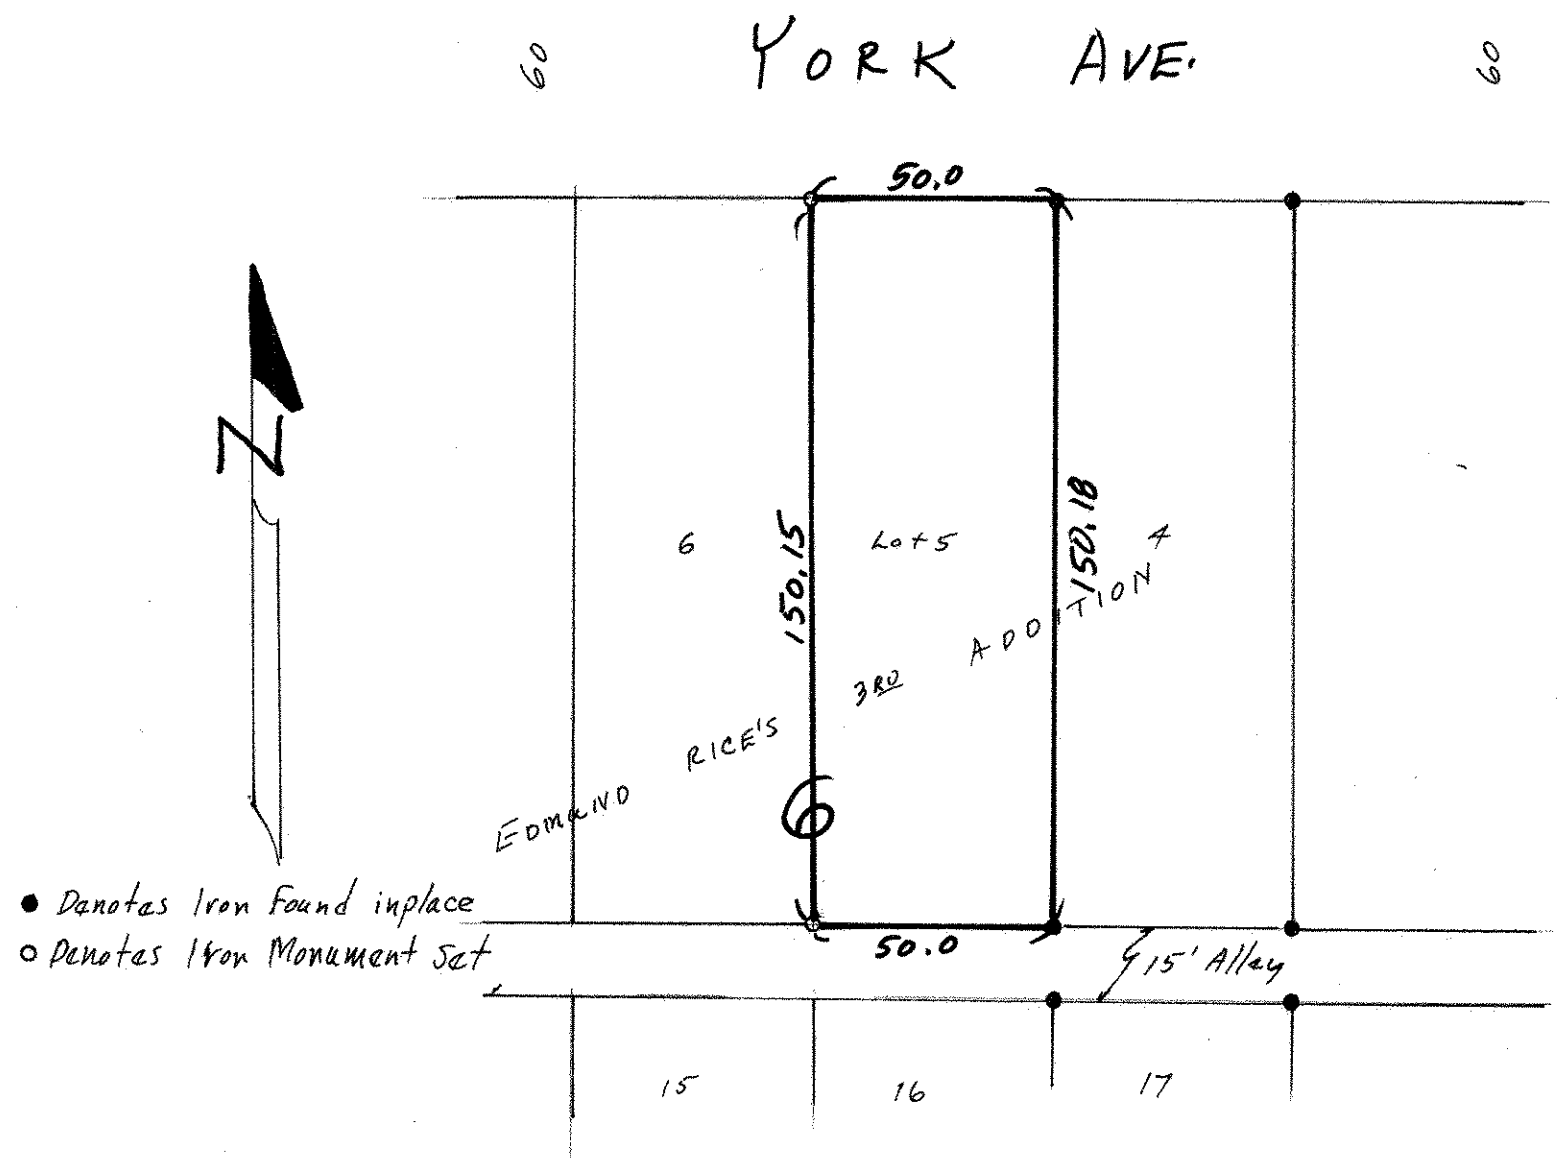
Description:
Lot 5, Block 6, Edmund Rice's 3rd. Addition
Ramsey County, Minnesota