NE 4 29 22

Certificate of Survey

From the office of

GEORGI- SCHMIDT & ASSOC. INC.

3092 No. Lexington Ave., Roseville, Mn. 55113
LAND SURVEYING
483-4408

I Hereby Certify that this plat shows a survey made by me of the property described on this plat, and that the corners are correctly placed as shown, and that all locations have been correctly shown. Irons shown Placed 8/64

Job Number: 73

Surveyed For Market Place Realty, Inc.
Irons shown as Set 11/78

Date July 24- 1978 (Voga Piletech)

Scale 1" = 300'

By Donald W Schmidt
REGISTERED LAND SURVEYOR

Description: (Contains 20.81 Acres, m.o.l.)

The East 639.74 feet of the SW1/4 of the NE1/4 of Section 4, T29N, R22W, and the West 180.0 feet of the South 350 feet of the SE1/4 of the NE1/4 of Section 4, T29N, R22W.
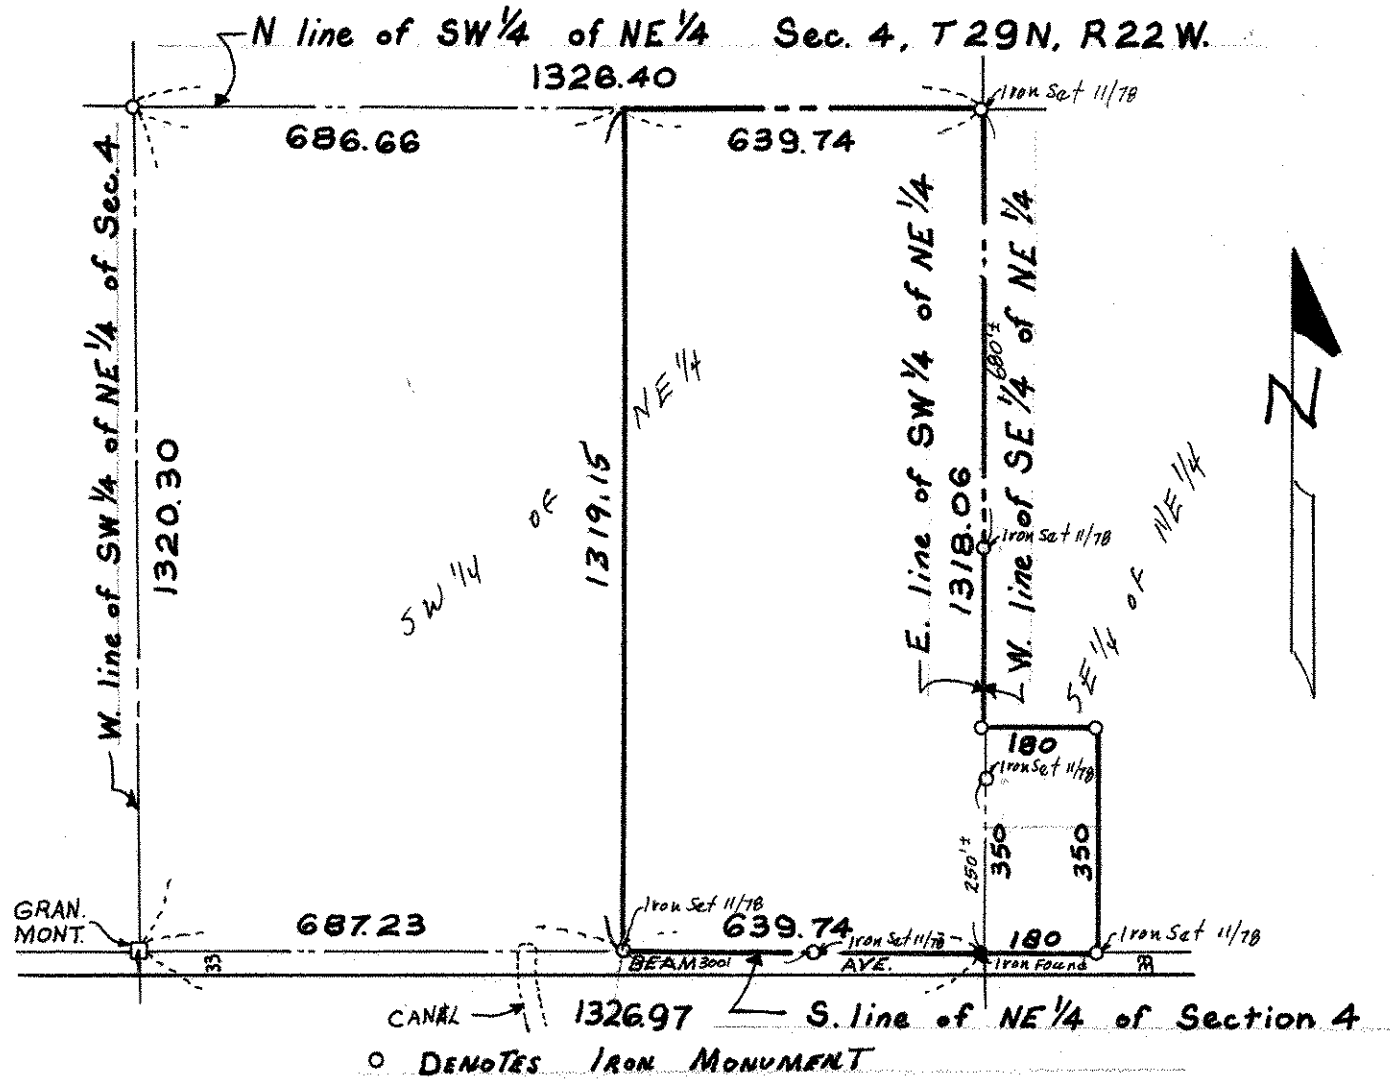
Ramsey County, Minnesota