NE 20 29 22

# Certificate of Survey

From the office of

**GEORGI- SCHMIDT & ASSOC. INC.**

3092 No. Lexington Ave., Roseville, Mn. 55113
LAND SURVEYING
483-4408

**I Hereby Certify that** this plat shows a survey made by me of the property described on this plat, and that the corners are correctly placed as shown, and that all locations have been correctly shown.

*Job Number:* 356

*Surveyed For* Jeff Maurer

*Date* June 1979

*Scale* 1" = 40'

By Donald W. Schmidt
REGISTERED LAND SURVEYOR

*Description:*

Lot 3, and the West 10.64 feet of Lot 2, Budde's Addition
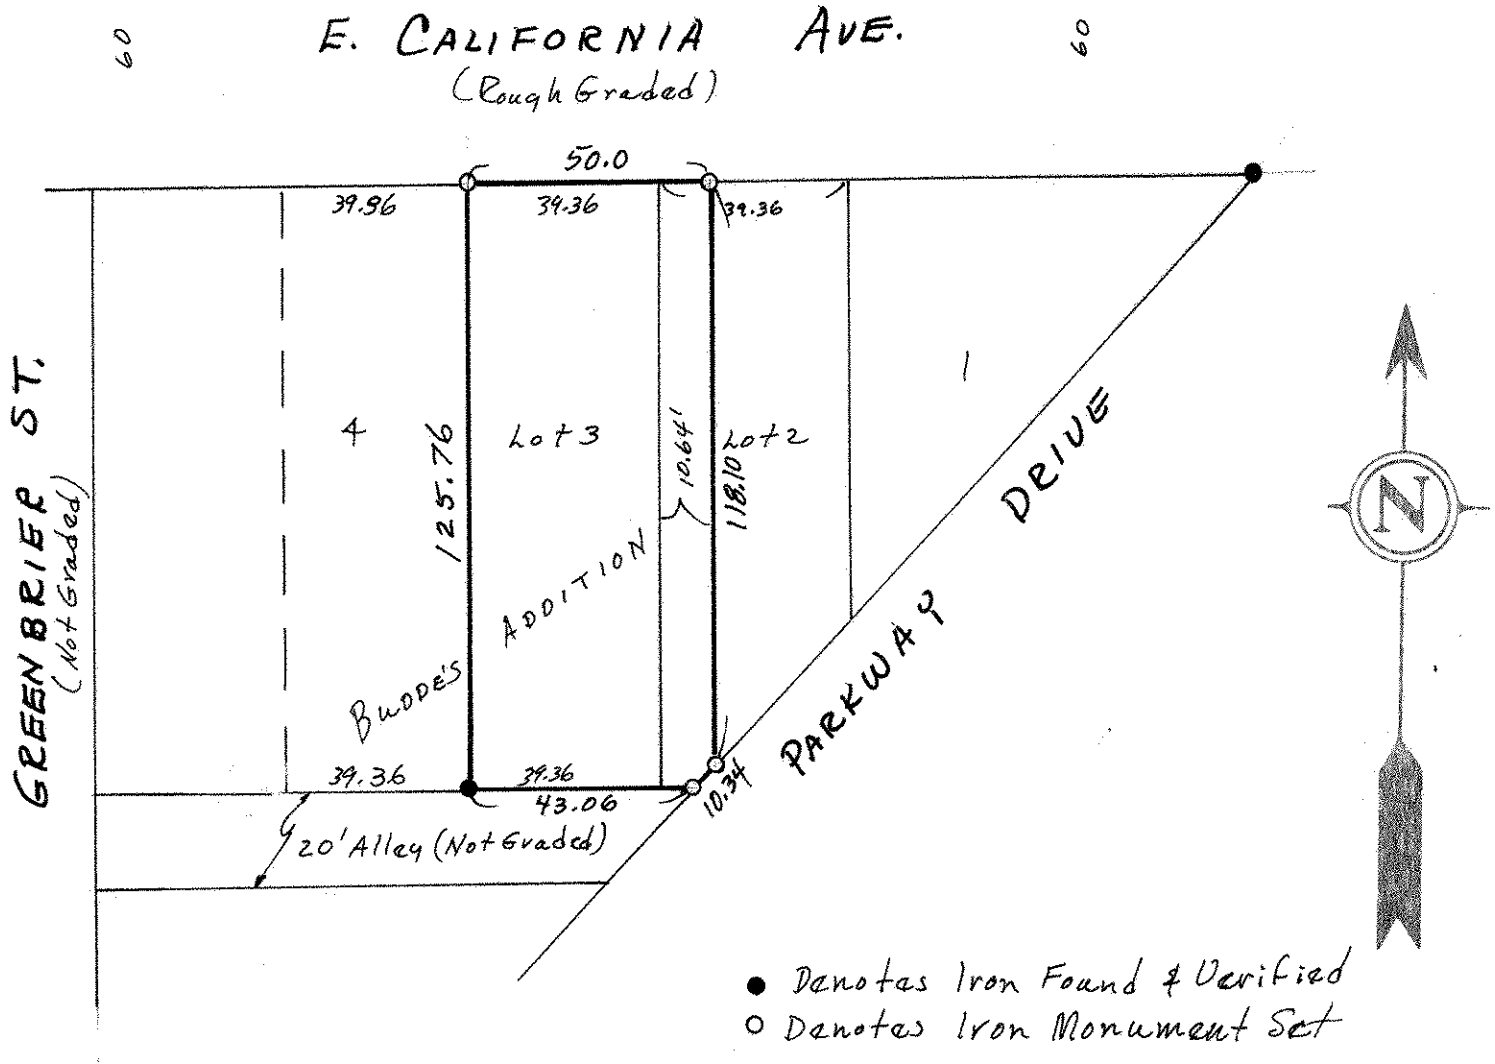
Ramsey County, Minnesota