SW 25 29 22

FROM THE OFFICE OF

# CHARLES O. GEORGI COMPANY

2215 West County Road B  Saint Paul, Minnesota 55113

REGISTERED CIVIL ENGINEER AND LAND SURVEYOR

## Certificate of Survey

*I Hereby Certify that* this plat shows a survey made by me of the property described on this plat, and that the corners are correctly placed as shown, and that all locations have been correctly shown.

***Surveyed For*** Tim Marrinan

***Date*** April, 1970

***Scale*** 1"=60'

By Charles O. Georgi
REGISTERED LAND SURVEYOR

***Description:***
The West 100 feet of lot 8 and 9, Block 9, Bartelmy Acres Second Addition, Ramsey County, Minnesota.

Description: All of lots 8 and 9, Block 9, Bartelmy Acres Second Addition, except the West 100 feet there of, and the West 10 feet of lots 6 and 7, Block 9, Bartelmy Acres Second Addition, Ramsey County, Minnesota.

Description: All of lots 6 and 7, Block 9, Bartelmy Acres Second Addition, except the West 90 feet thereof, Ramsey County, Minnesota.

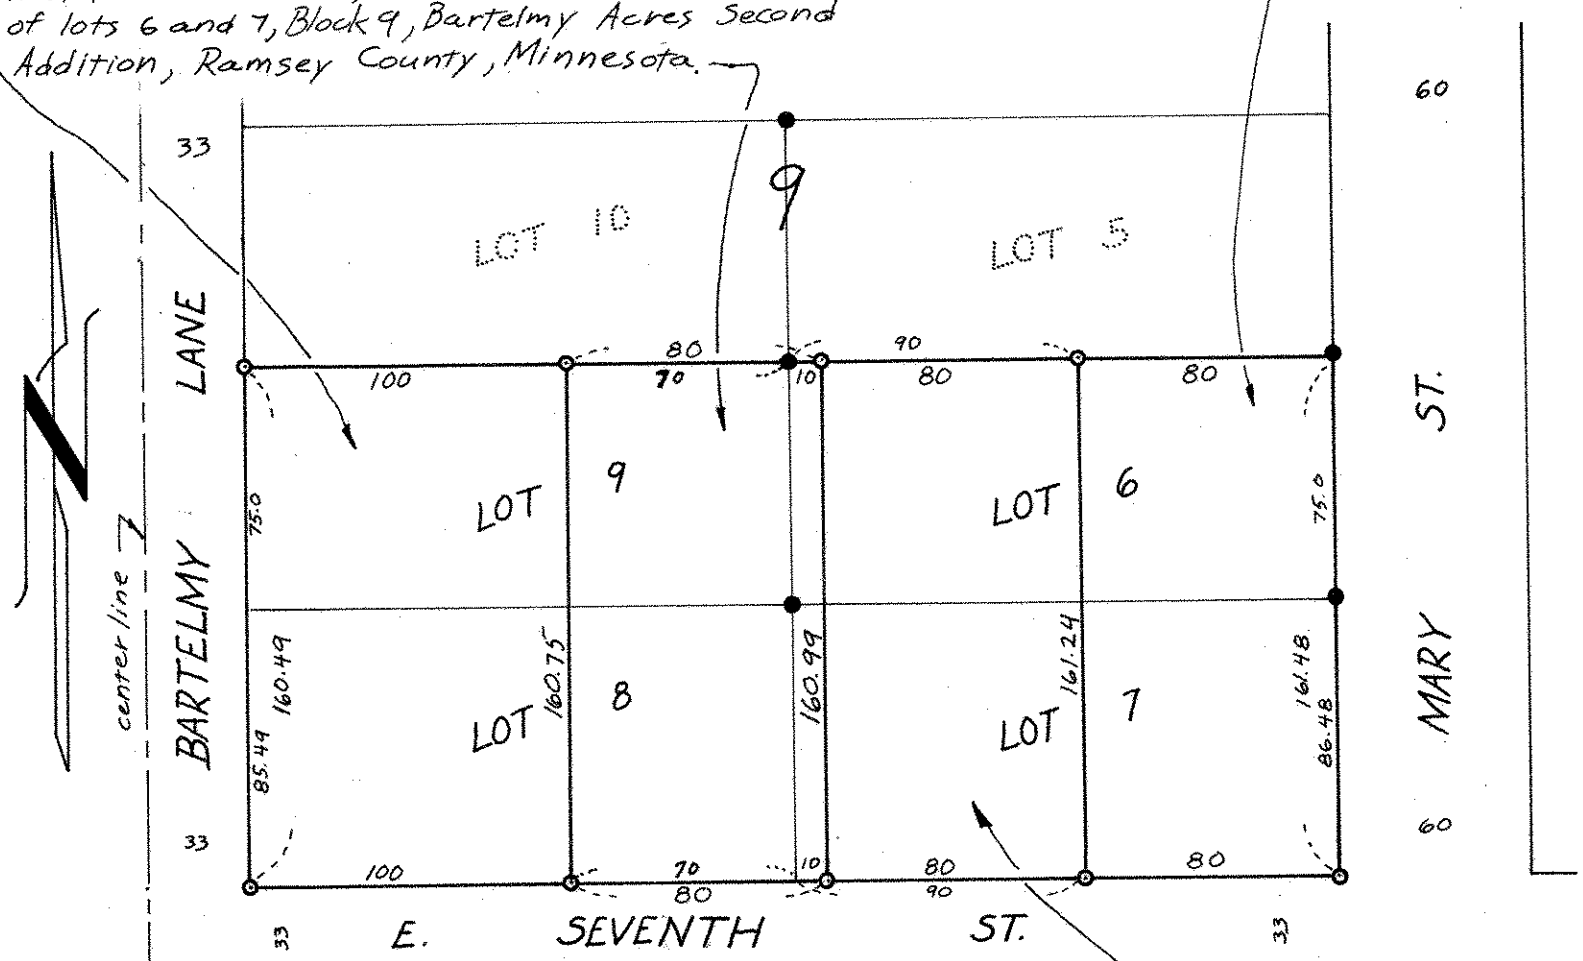


○ Denotes Iron Pipe Monument
● Denotes Iron Pipe Monument found in place.

Description: The East 80 feet of the West 90 feet of lots 6 and 7, Block 9, Bartelmy Acres Second Addition, Ramsey County, Minnesota.