

7059.60
1309.83
749.97

90.
640
757


9059.08
1329.87
729.7

443.87
1582.87
360.00

640
75
735

Deeds

3+60.76 Brunson Str. 60

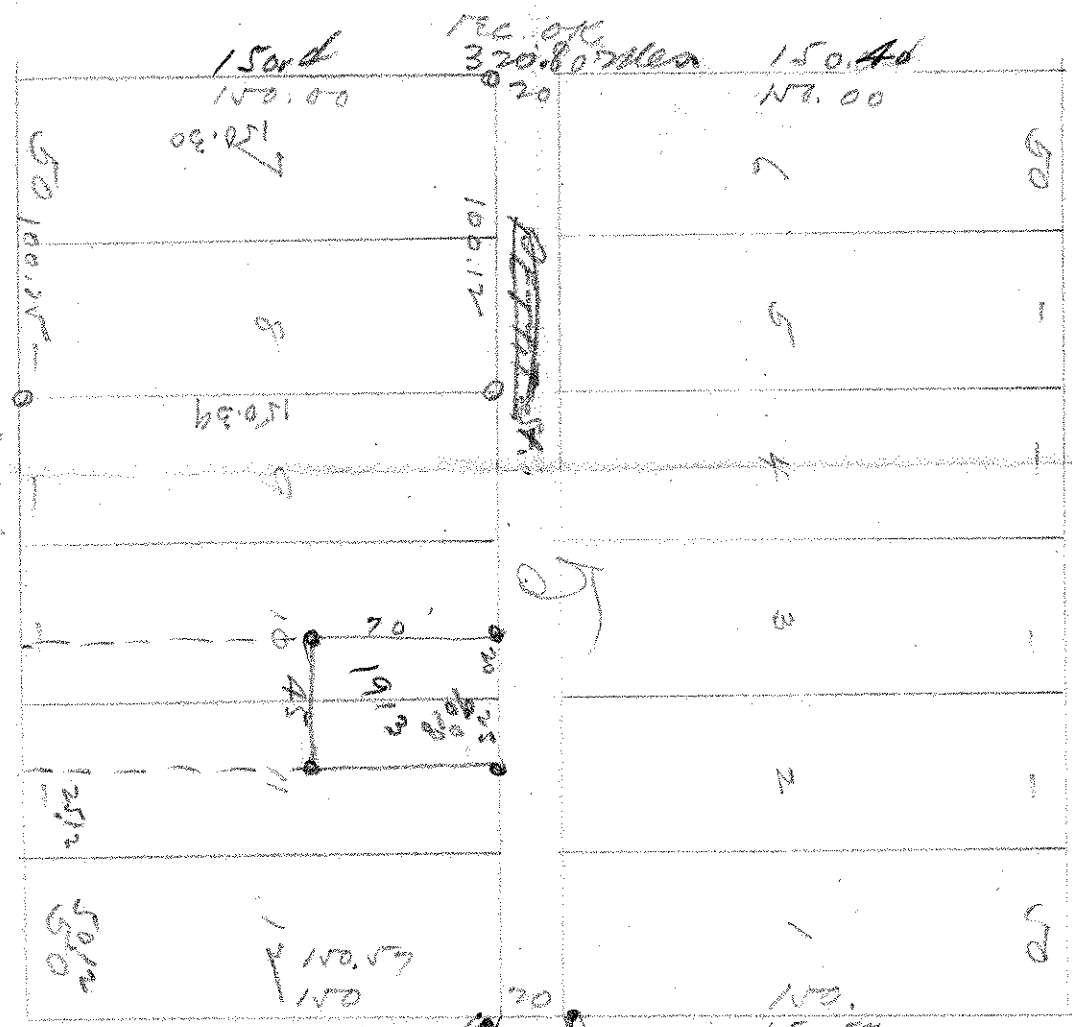

Partage Str.

Hoppers Str.

Bradley Str.

Partage Str.

3+60.76
300.76 meas.
3473.06

370
380
350
370.86
381.11