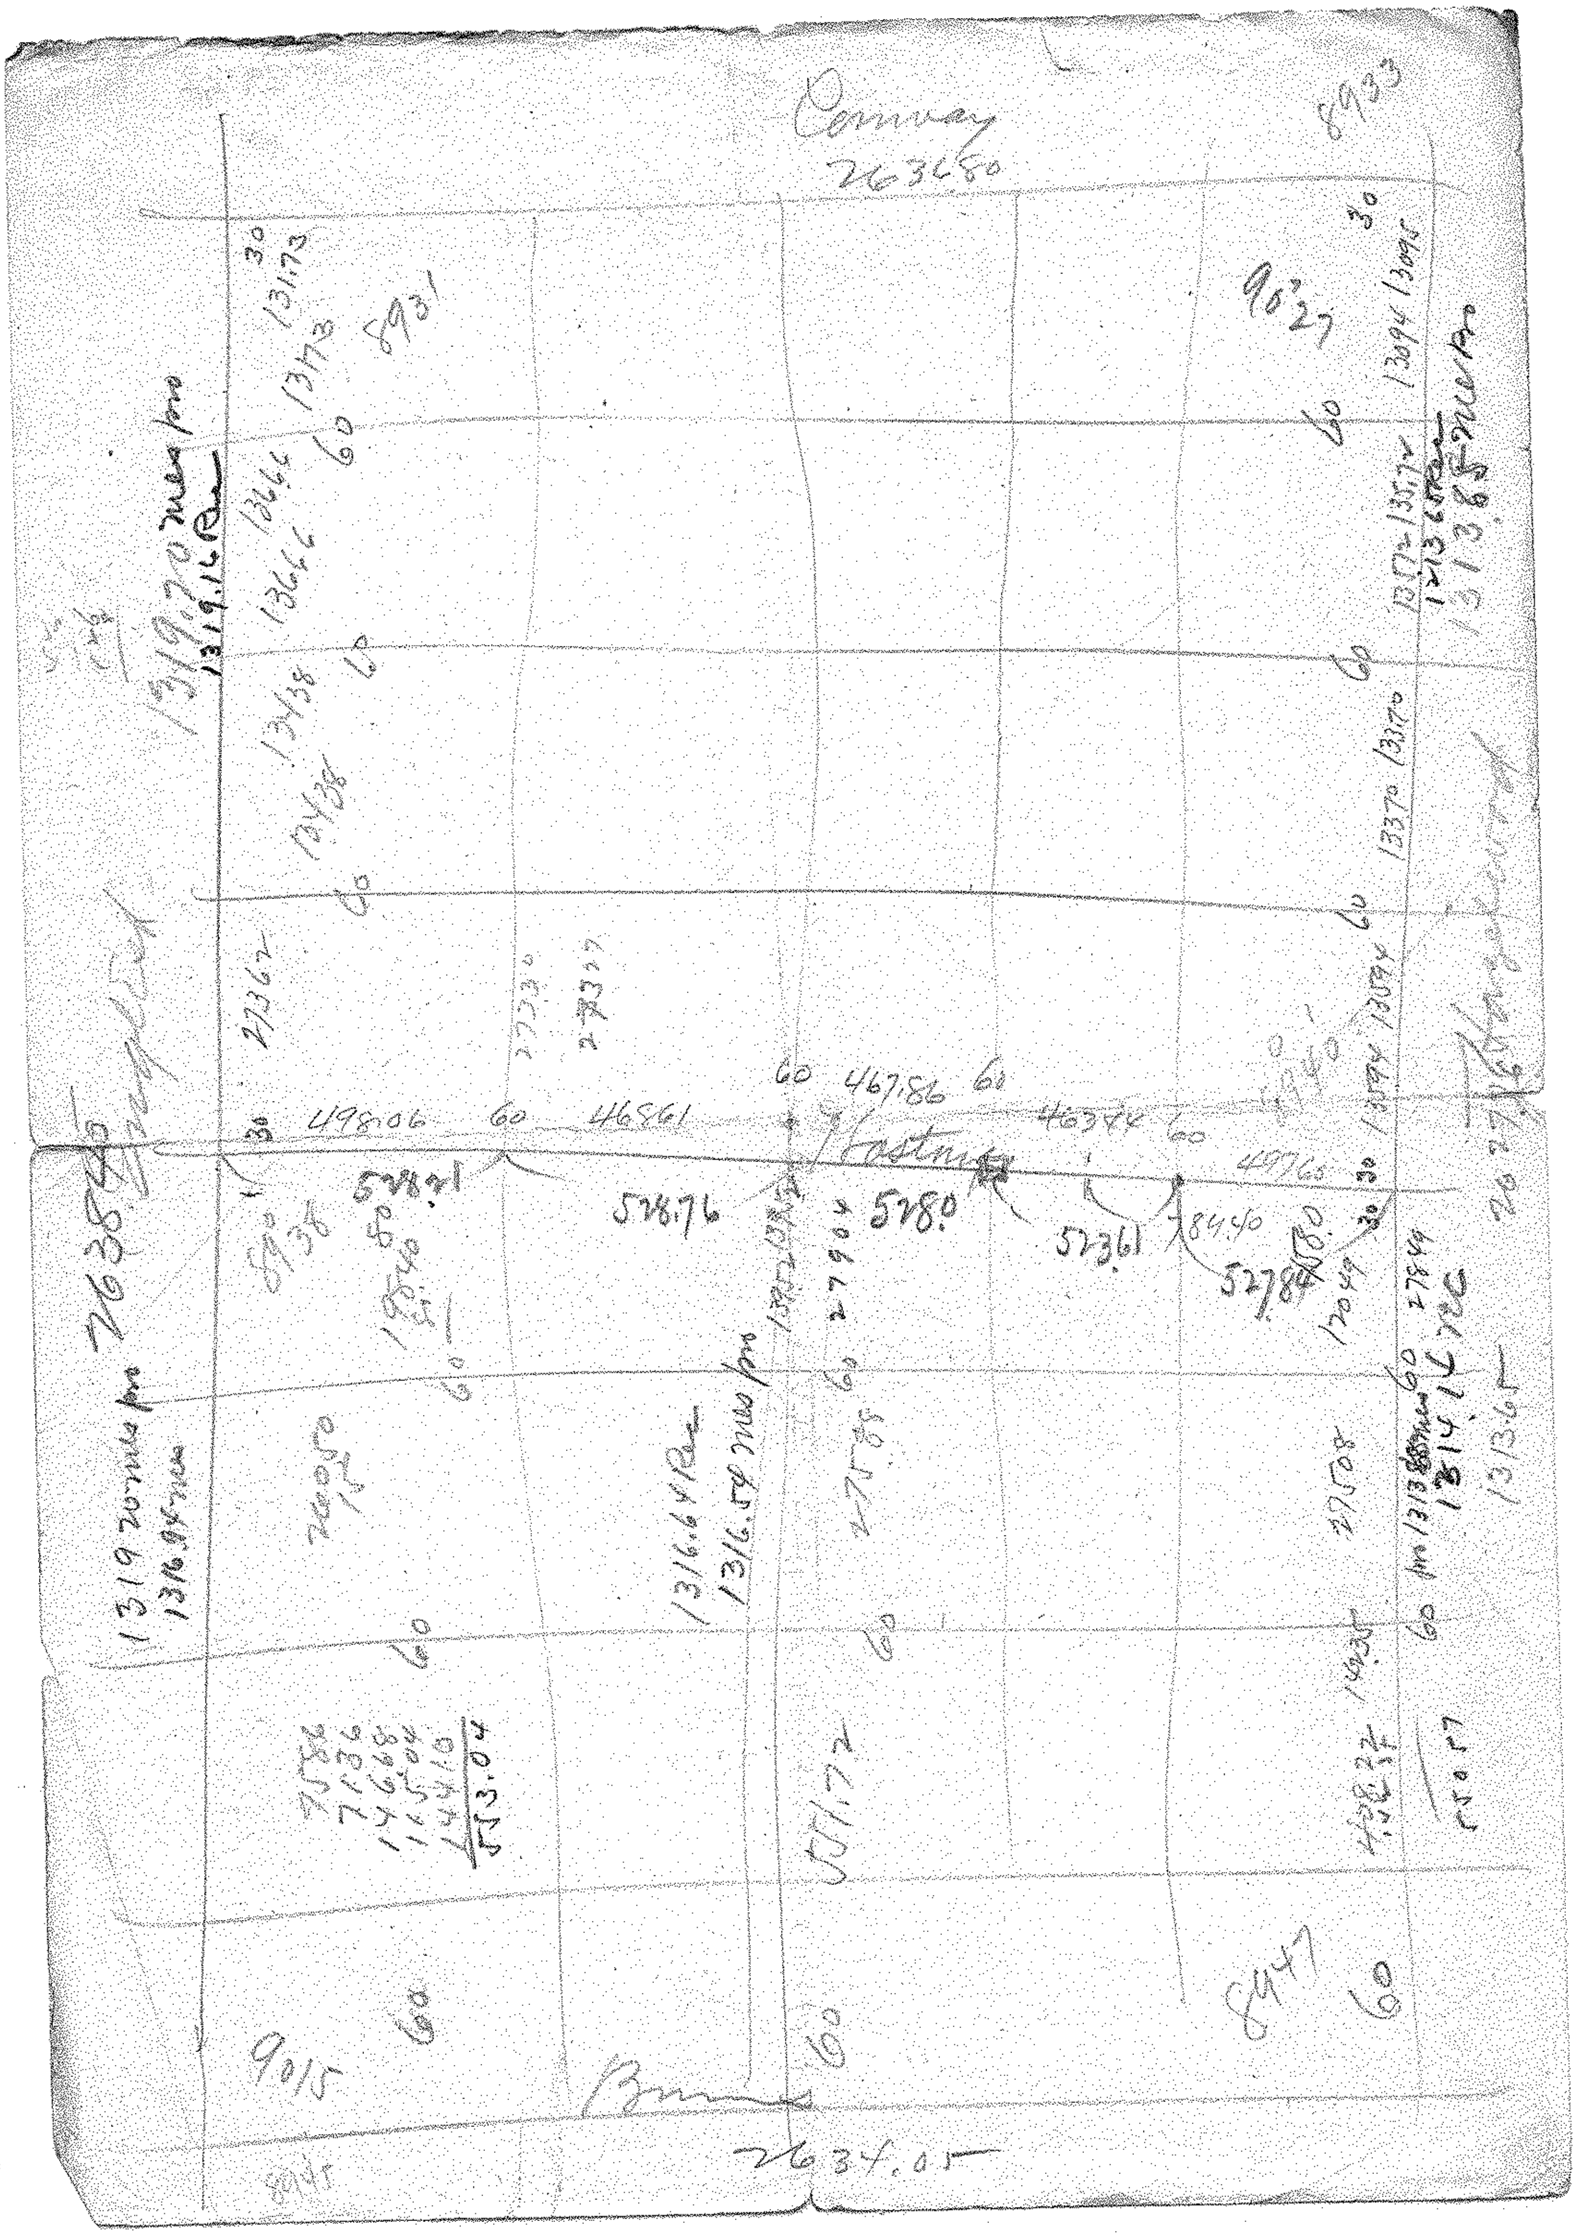

Conway
2636.80
8933
8931
90°27
1319.70 meas pro
1319.14 Re
1313.65 meas pro
498.06
468.61
467.86
463.44
497.60
528.71
528.76
5280
523.61
84.40
527.84
1319.70 meas pro
1316.94 Re
1316.64 Re
1316.59 meas pro
1313.65
1314.16
553.04
551.72
9015
8947
2634.05