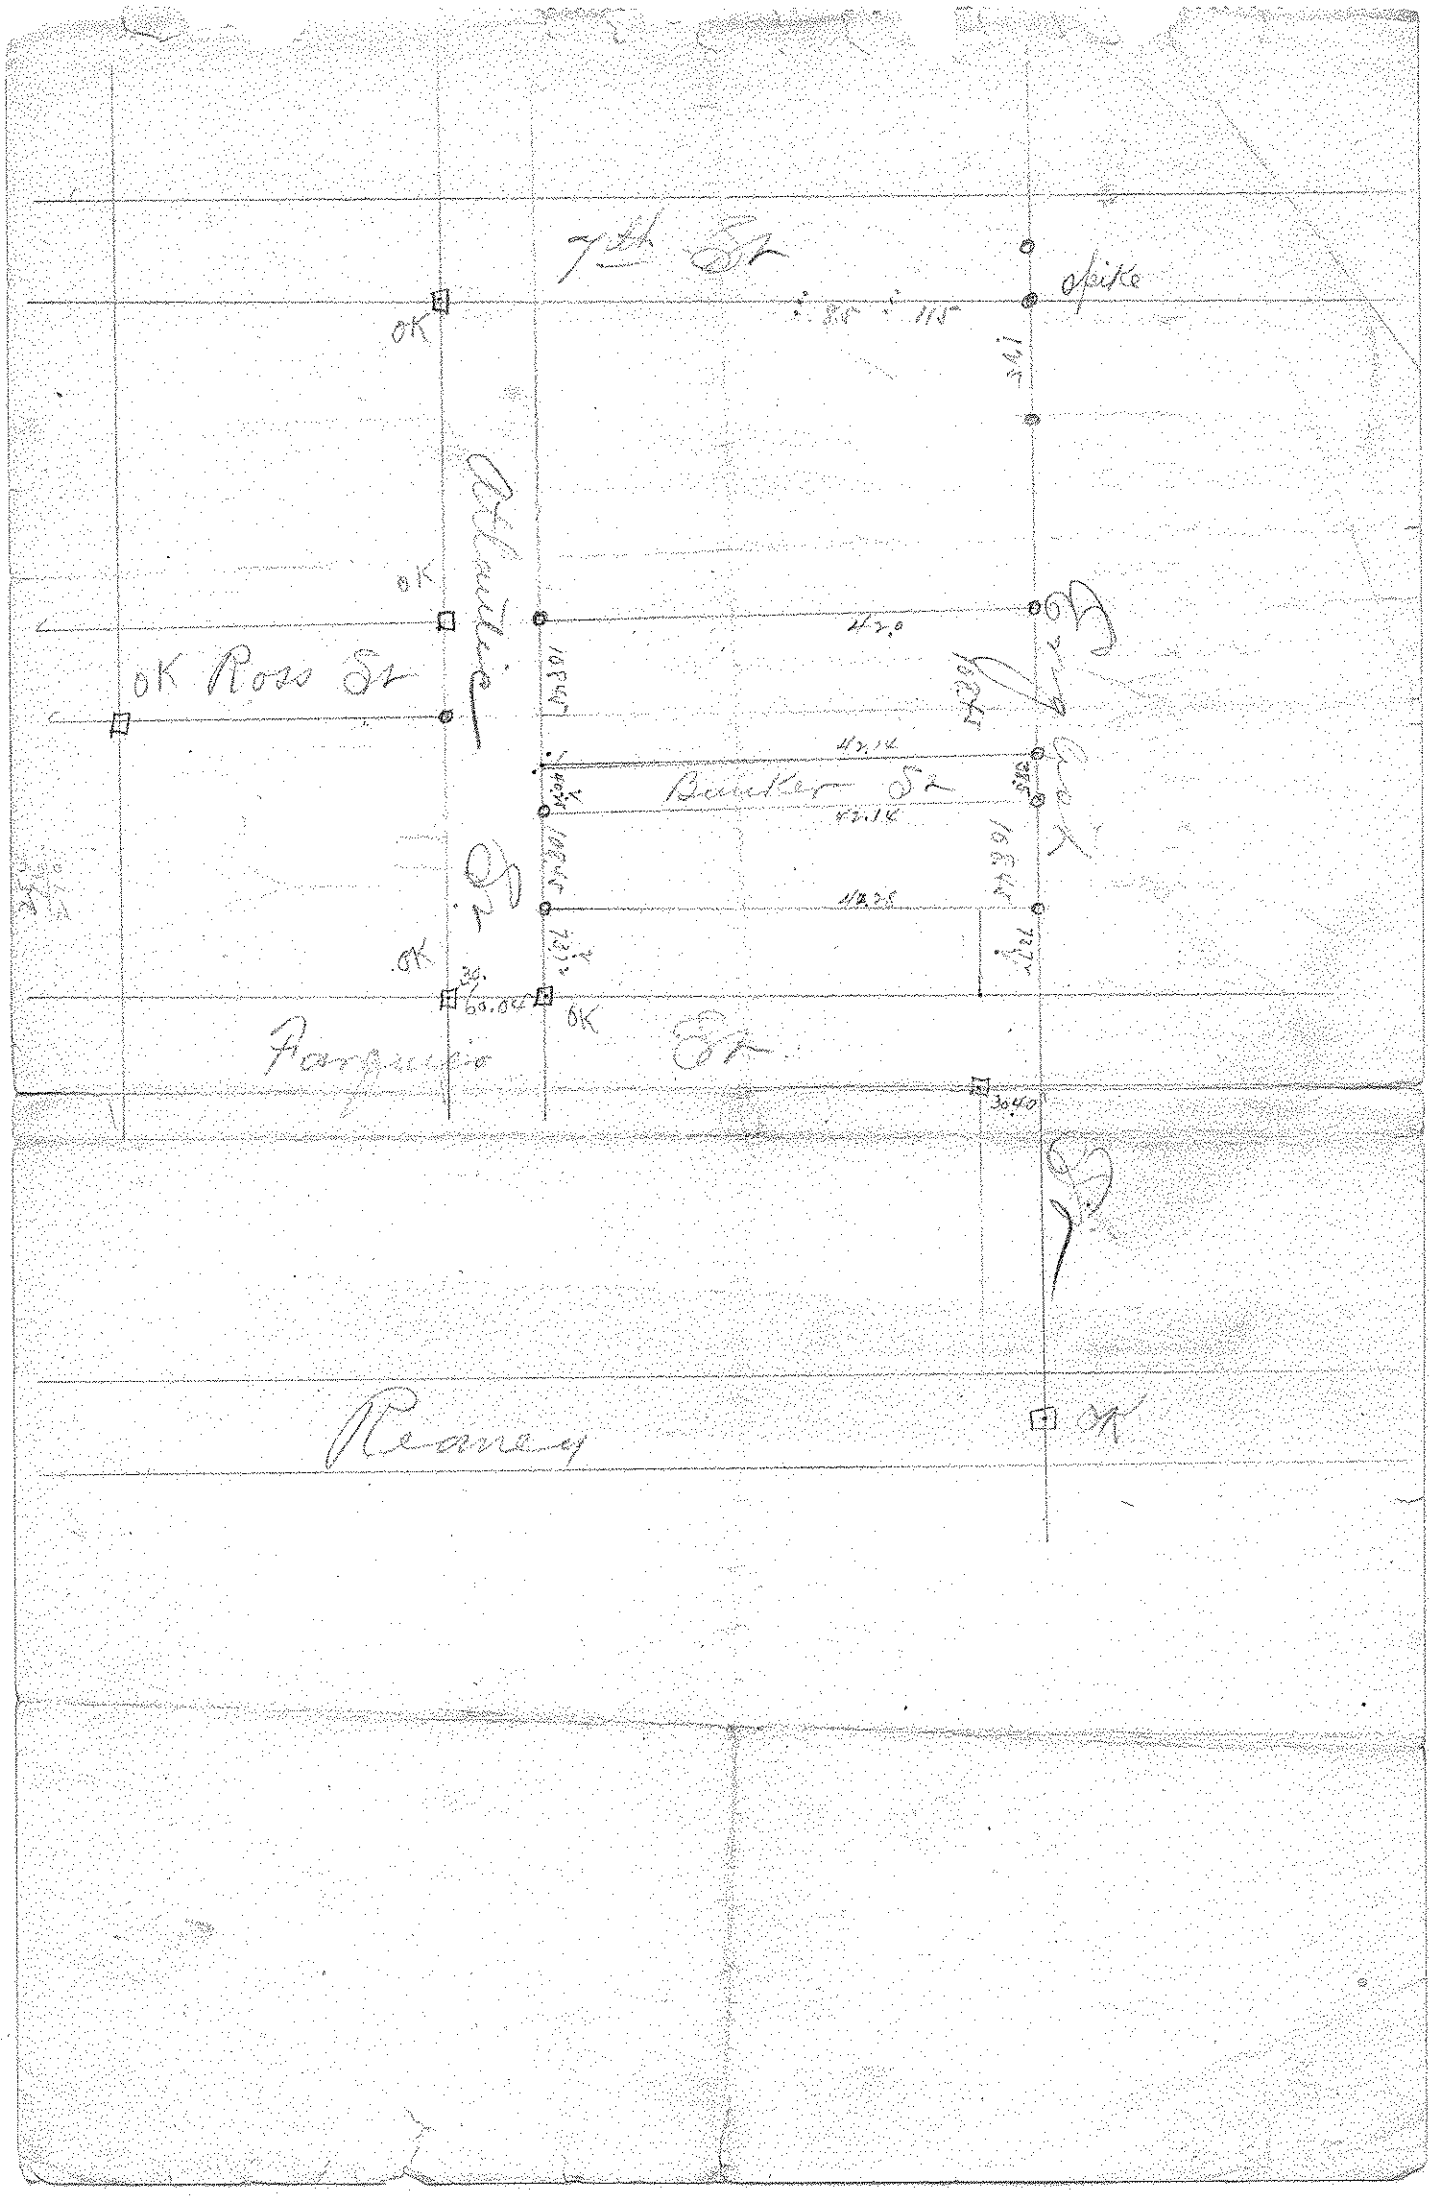
7th St
Spike
OK
OK
OK Ross St
Atlantic St
Bunker St
OK
OK
Farquhar St
Reaney
OK