


PART OF
LOTS 7, 8, & 9. BLOCK 14
N
ROBERT & RANDALL'S ADD.

SCALE 1 IN. = 20 FT.

JOHN BIRVINE, SURVEYOR.
ROOM 416 GLOBE BLDG
ST PAUL MINN.
JULY 27. 07.

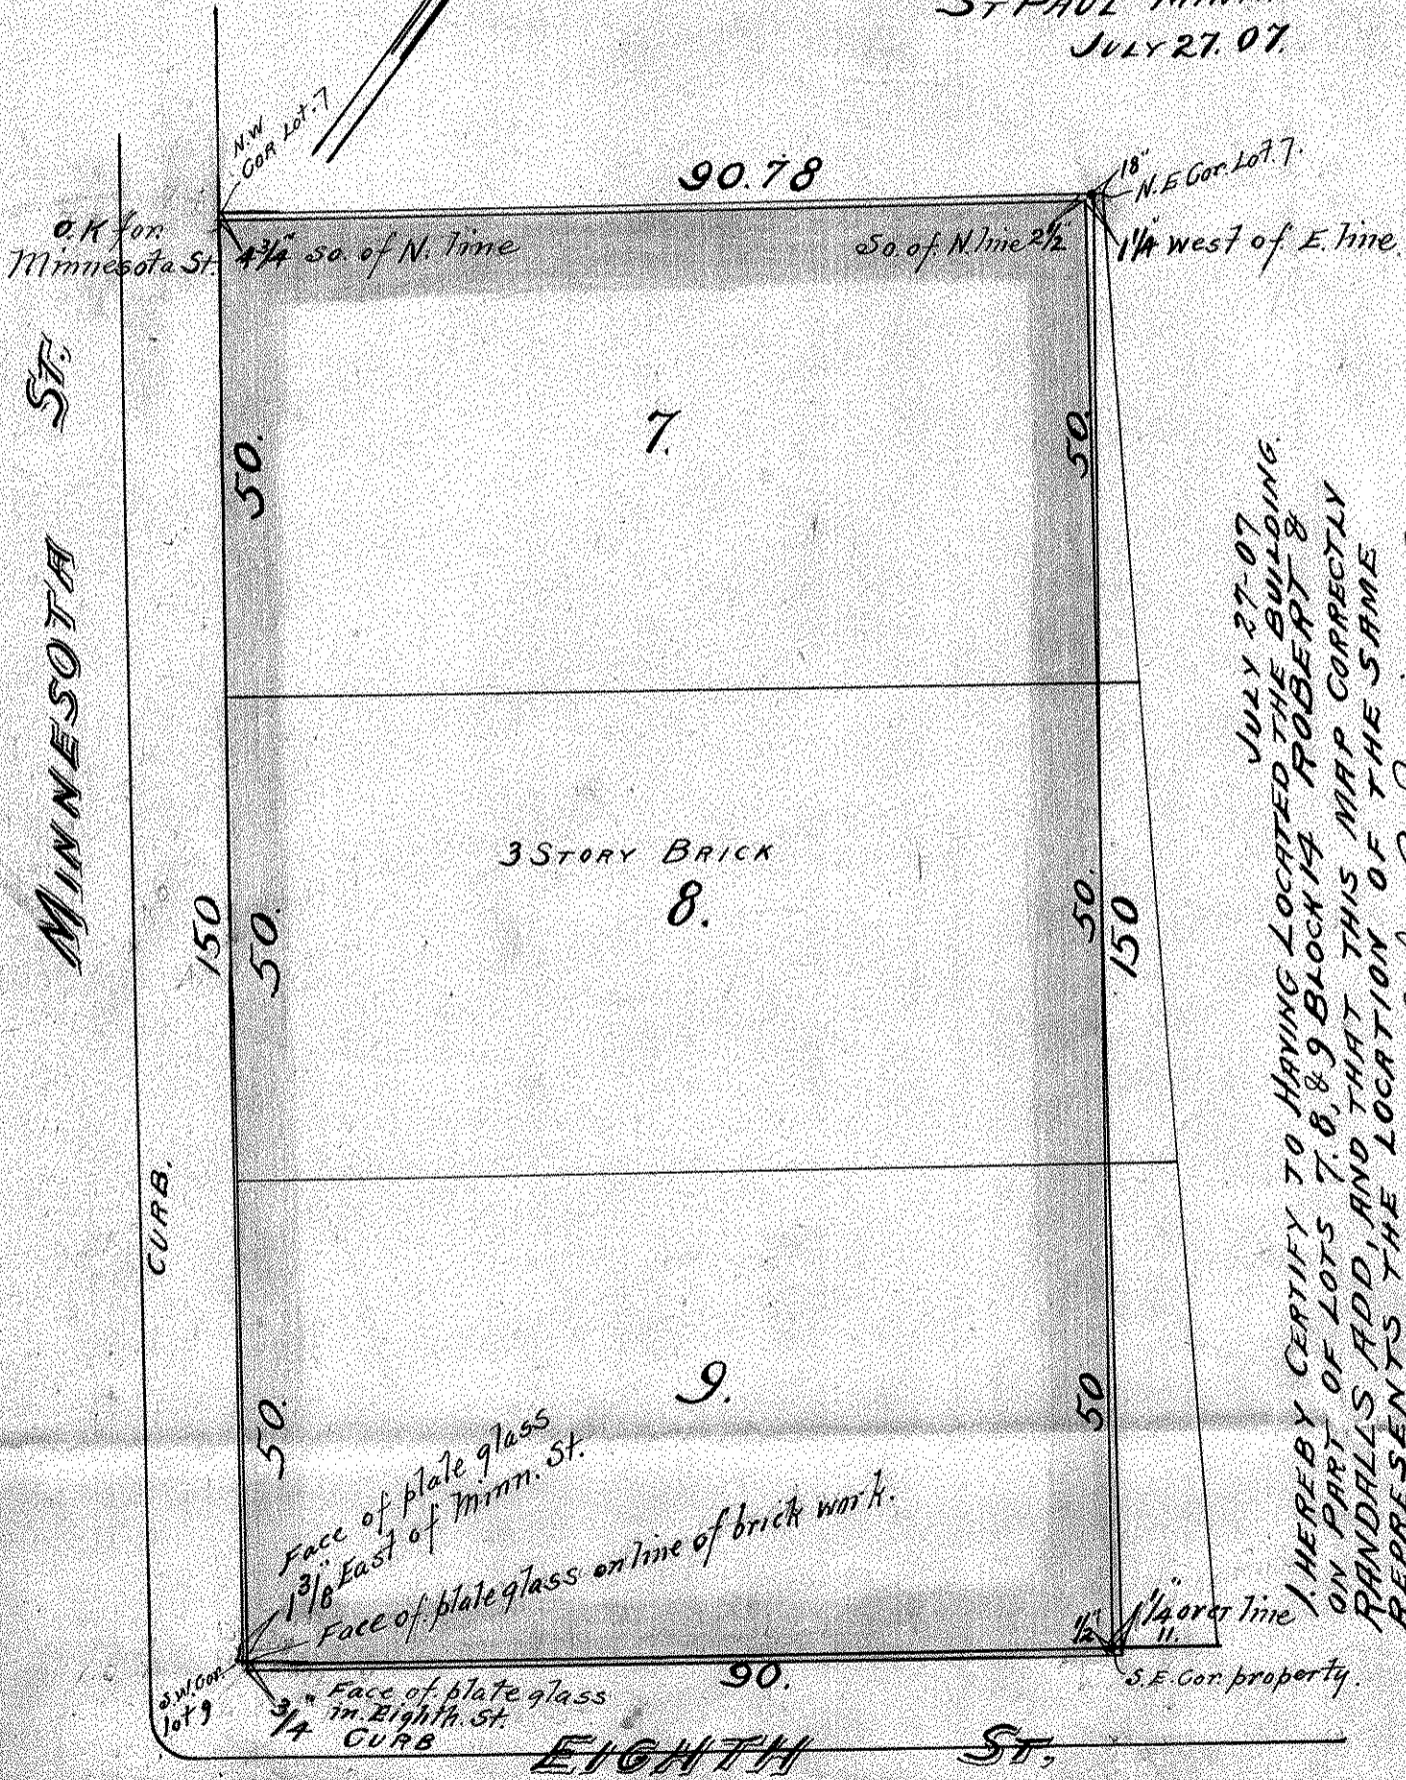

JULY 27-07
I HEREBY CERTIFY TO HAVING LOCATED THE BUILDING
ON PART OF LOTS 7, 8, & 9 BLOCK 14 ROBERT &
RANDALLS ADD., AND THAT THIS MAP CORRECTLY
REPRESENTS THE LOCATION OF THE SAME

John B. Irvine SURVEYOR.