31 29 22

LOTS 1 AND 2 BLOCK 14
ROBERTS AND RANDALL'S ADD'N.

Scale 10. FEET pr INCH.

▫ indicates Stake.
∘ indicates Hole in Walk.
▪ SURVEYED FOR CRITERION THEATRE Co.

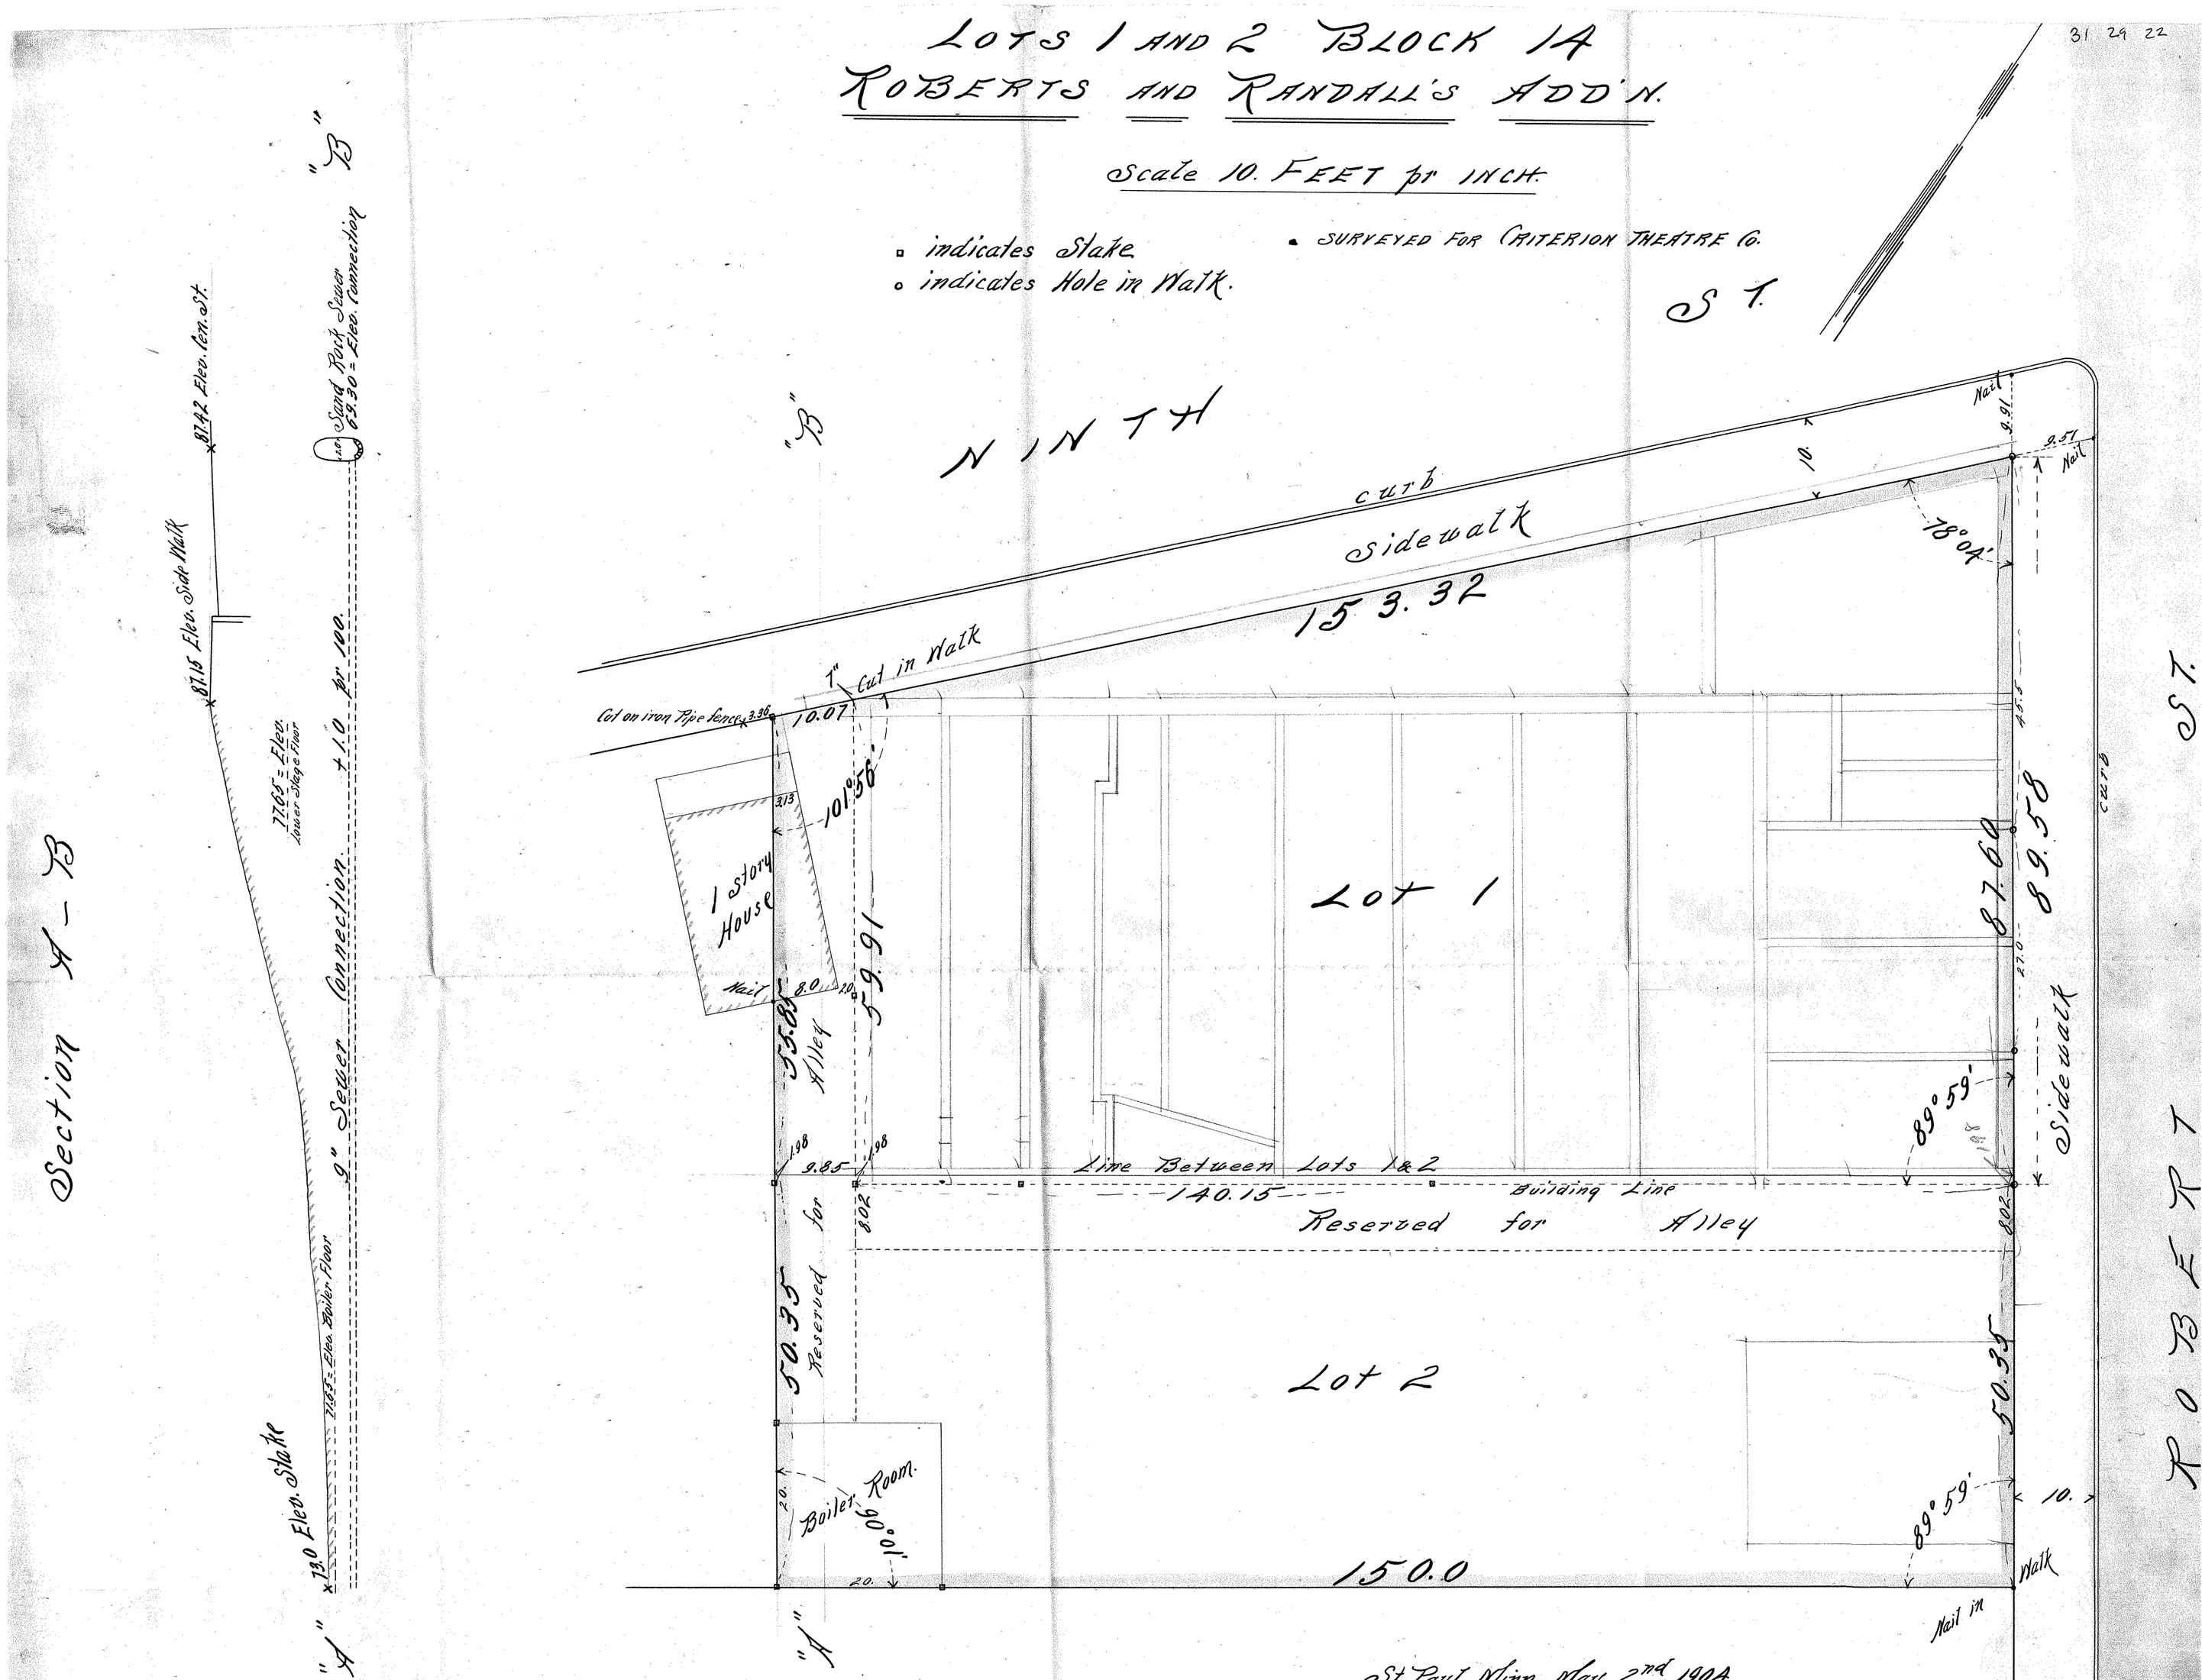

St. Paul Minn. May 2nd 1904

I hereby certify that this diagram correctly represents "LOTS 1&2 BLOCK 14 ROBERTS & RANDALL'S ADD." as surveyed by me April 29th 1904

John B. Irvine
County Surveyor Room 16 Court House.