


PART OF LOT 4 BLOCK 14 ROBERT & RANDALL'S ADD.

Scale 10 Feet pr. inch.

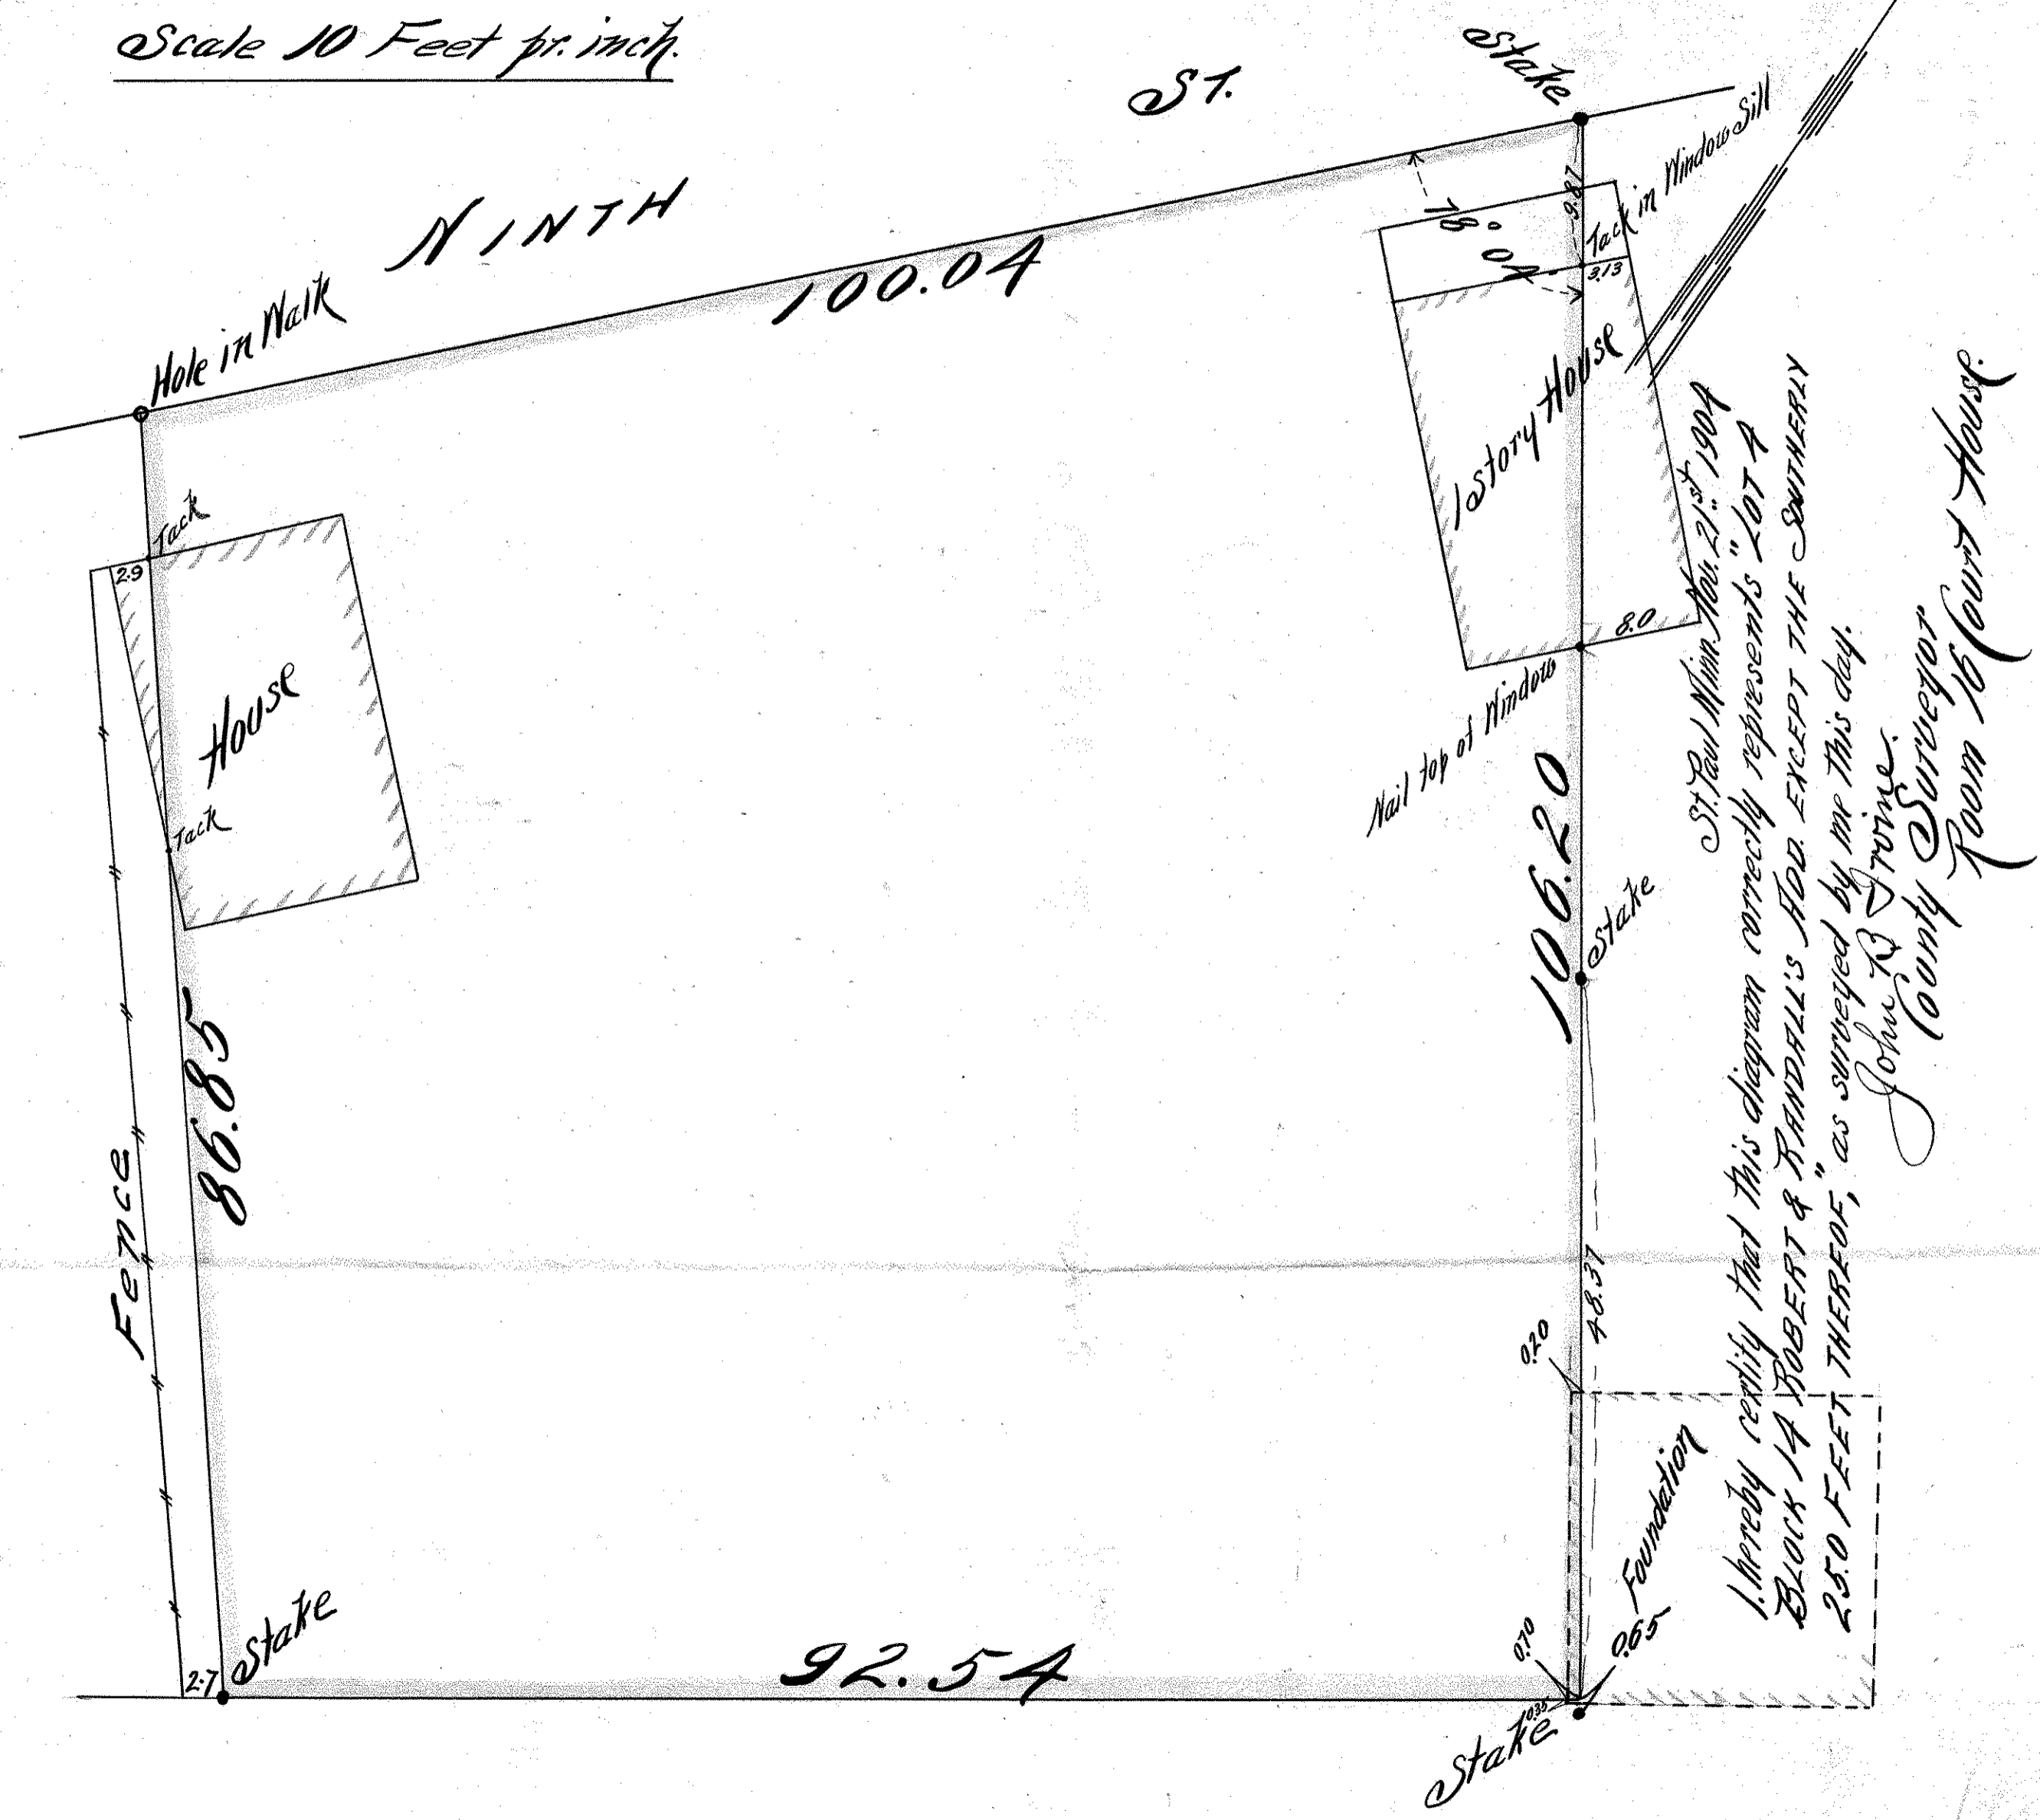

St. Paul Minn Nov. 21st 1904
 I hereby certify that this diagram correctly represents "LOT 4
 BLOCK 14 ROBERT & RANDALL'S ADD. EXCEPT THE SOUTHERLY
 25.0 FEET THEREOF," as surveyed by me this day.
 John B. Irvine.
 County Surveyor Room 16 Court House.

92.54

106.20

State

Nail top of Window

State

Foundation

1-story House

House

NINTH

ST.

100.04

86.85

Fence

Hole in Walk

Tack

Tack

Tack in Window Sill

State

0.20

48.37

0.65

0.70

State

8.0

2.87

2.13

78° 04'