


No. *10*  
**LOTS 4 & 5 & PART OF LOT 2.**  
 LYING BETWEEN THE E'LY LINE OF LOT 5 &  
 THE W'LY LINE OF LOT 4 PRODUCED TO NINTH ST.  
**Block 13.**  
**ROBERT & RANDALL'S ADD.**

JOHN BIRVINE, SURVEYOR.  
 408 GLOBE BLD'G.  
 ST PAUL, MINN.  
 FEB. 23-10.  
 SCALE 10ft per inch.

ST.

E NINTH

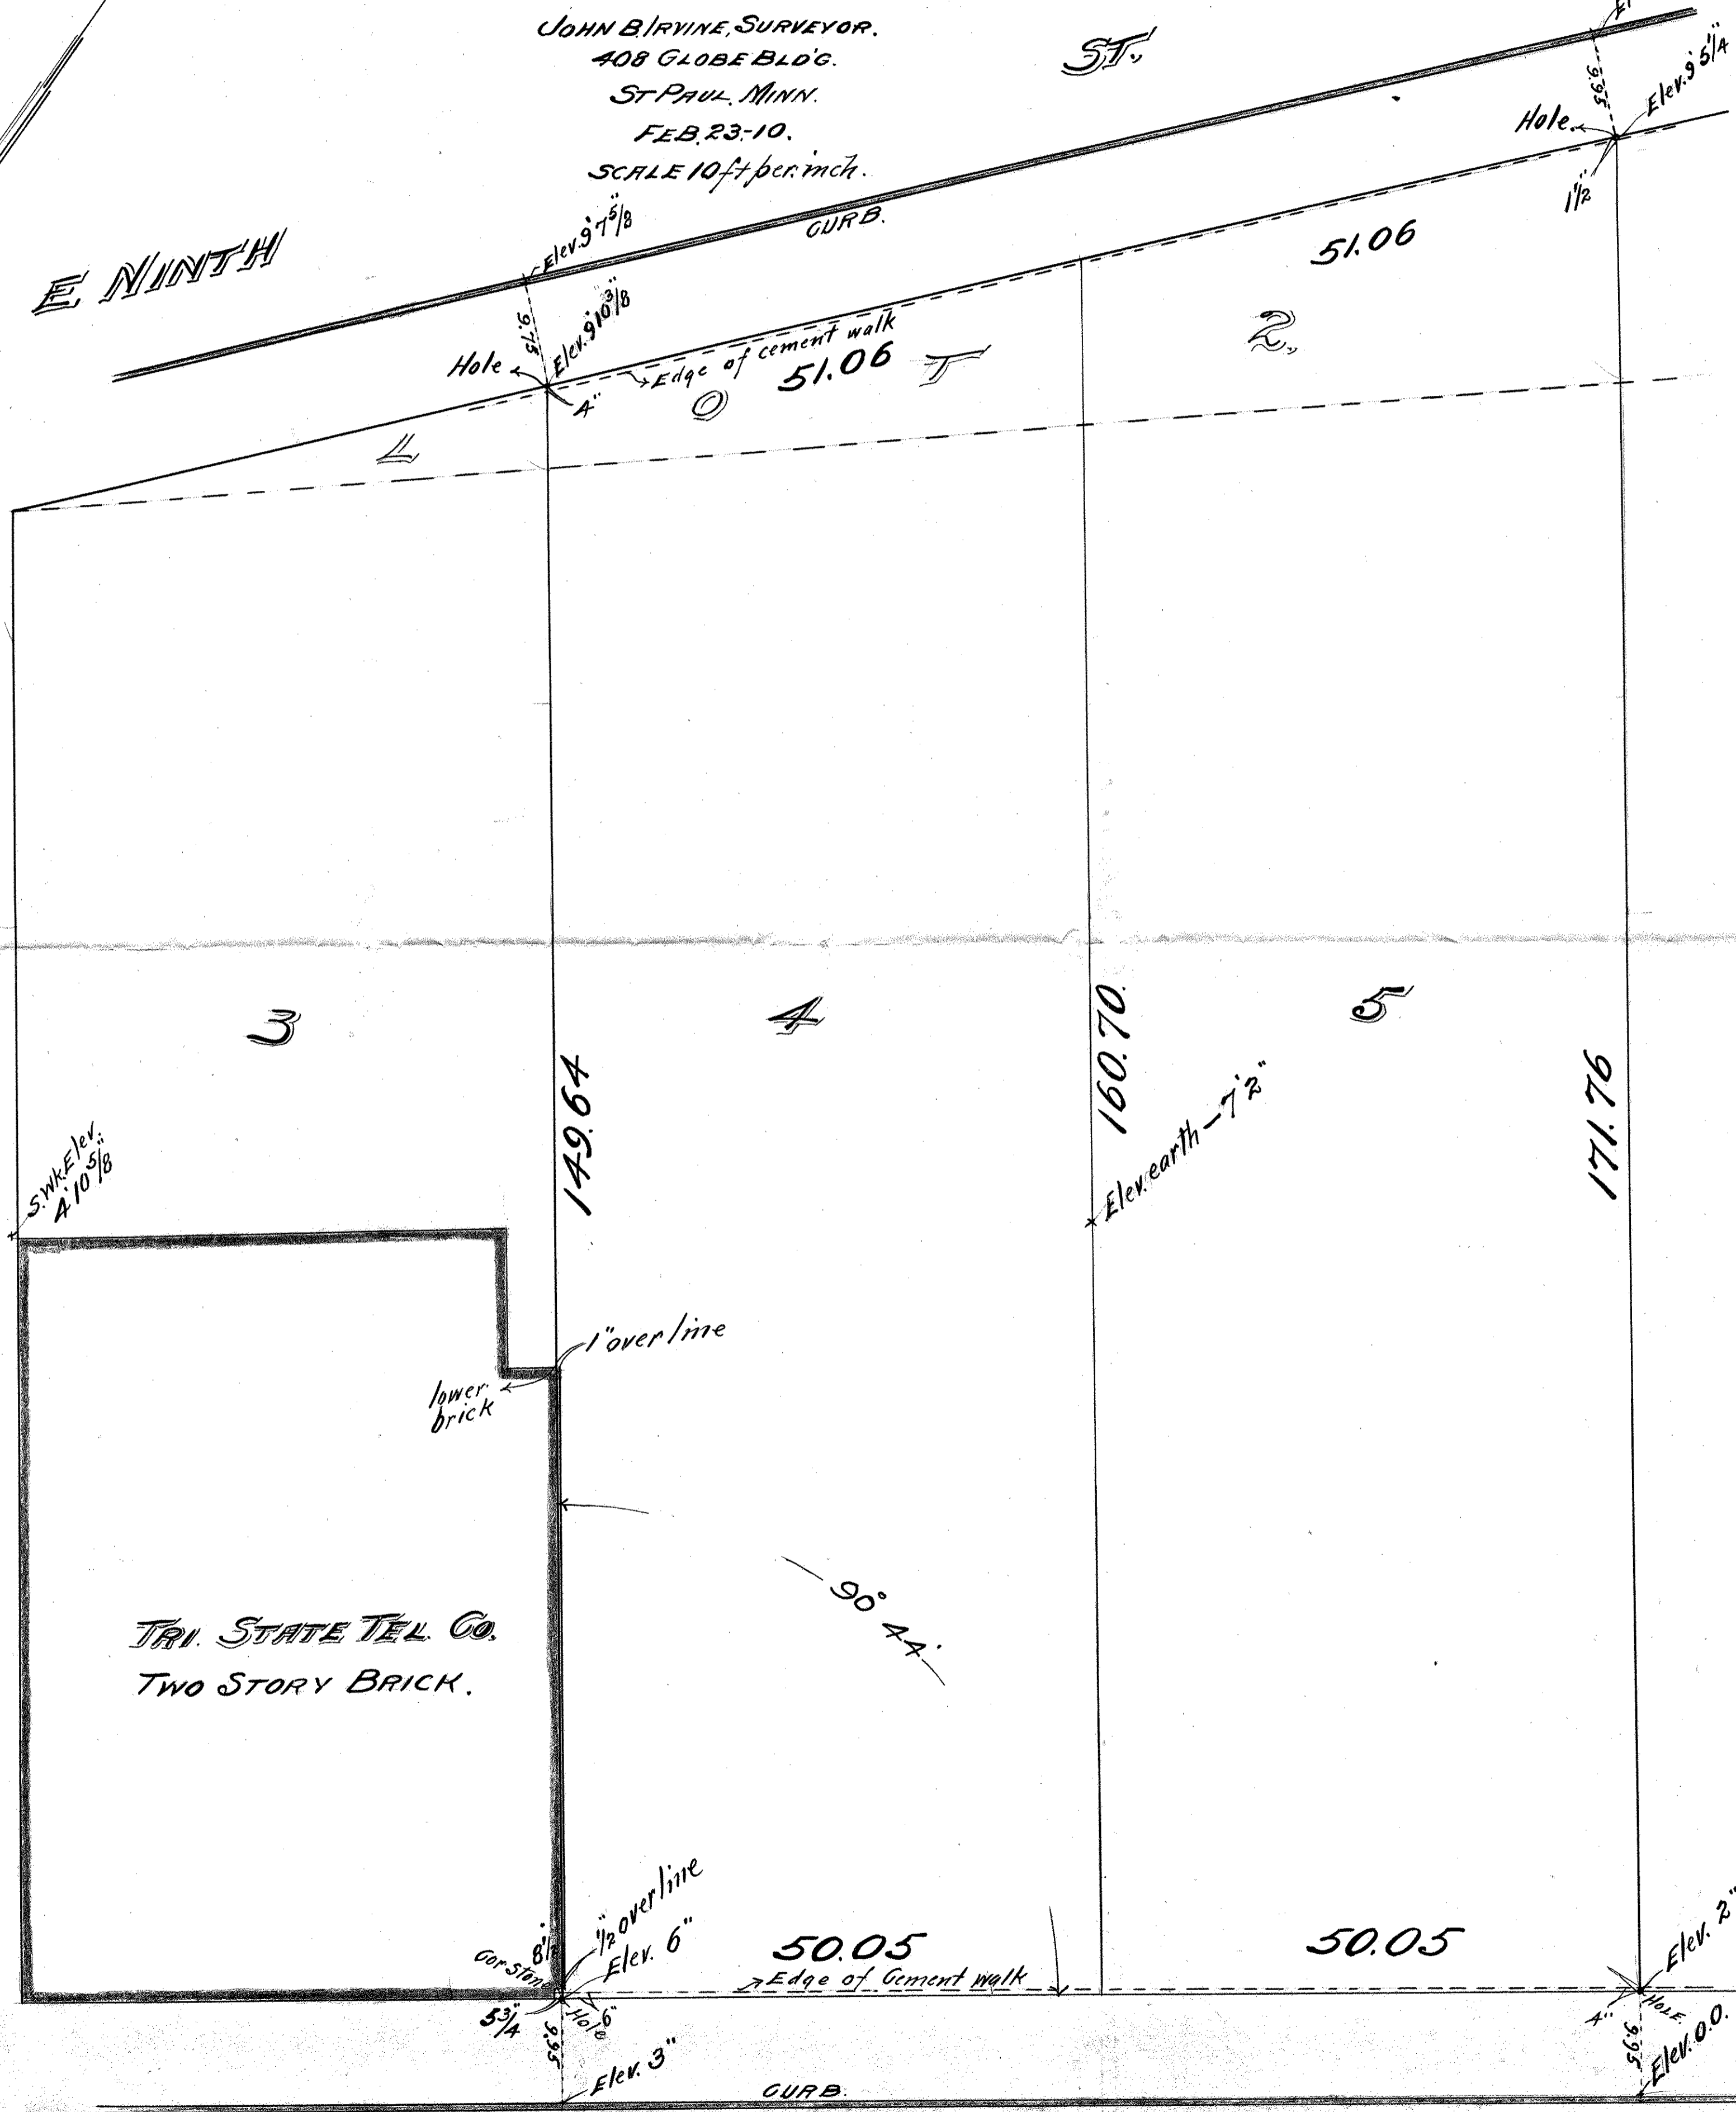

ST.

CEDAR

3

4

5

S.W. Elev. 2' 10 5/8"

149.64

160.70

171.76

lower brick  
1" over line

TRI. STATE TEL. CO.  
TWO STORY BRICK.

90° 44'

Car Stop 8"  
5 3/4"  
1/2" over line Elev. 6"  
Hole Elev. 3"  
CURB.

50.05  
Edge of Cement Walk

50.05

Hole Elev. 2"  
Hole Elev. 0.0"

EIGHTH

ST.