


SW 29-22

GOMSTOCK AND DAVIS INC.

3092 N. LEXINGTON AVE. ST. PAUL, MN. 55113 483-4408

SURVEYED FOR: Elizabeth Brzoska

DESCRIPTION: The East 70 feet of the West 195 feet of Lots 19 and 20, Block 3, Rogers and Hendricks Acre Lots No. 2, Ramsey County, Minnesota.

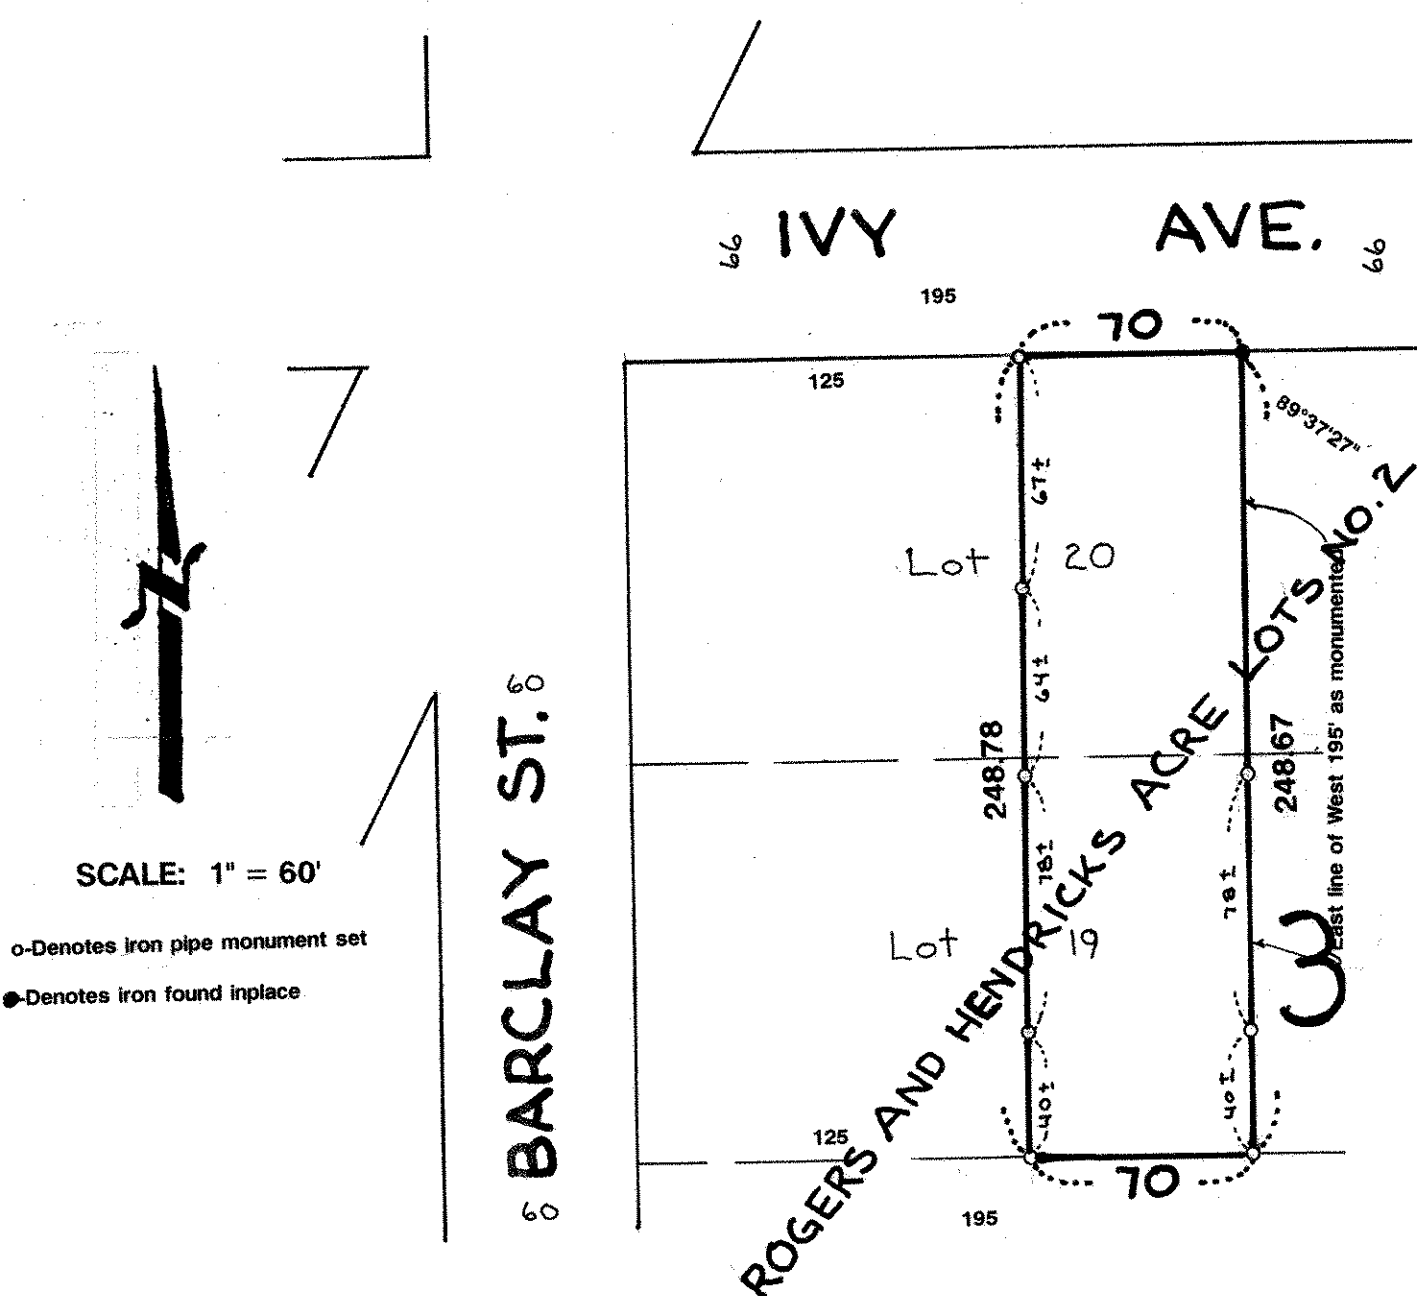

SCALE: 1" = 60'

- o-Denotes iron pipe monument set
- Denotes iron found in place

I hereby certify that this survey, plan plat, preliminary plat or report was prepared by me or under my direct supervision and that I am a duly Registered Land Surveyor under the laws of the State of Minnesota.

10459	9/13/93	931366	
Reg. No.	Date	Job No.	Book No.