29-22

COMSTOCK AND DAVIS INC.

3092 N. LEXINGTON AVE. ST. PAUL, MN. 55113 483-4408

Sheet 1 of 2 sheets

SURVEYED FOR: Alan Engebretson

See sheet 2 for Descriptions

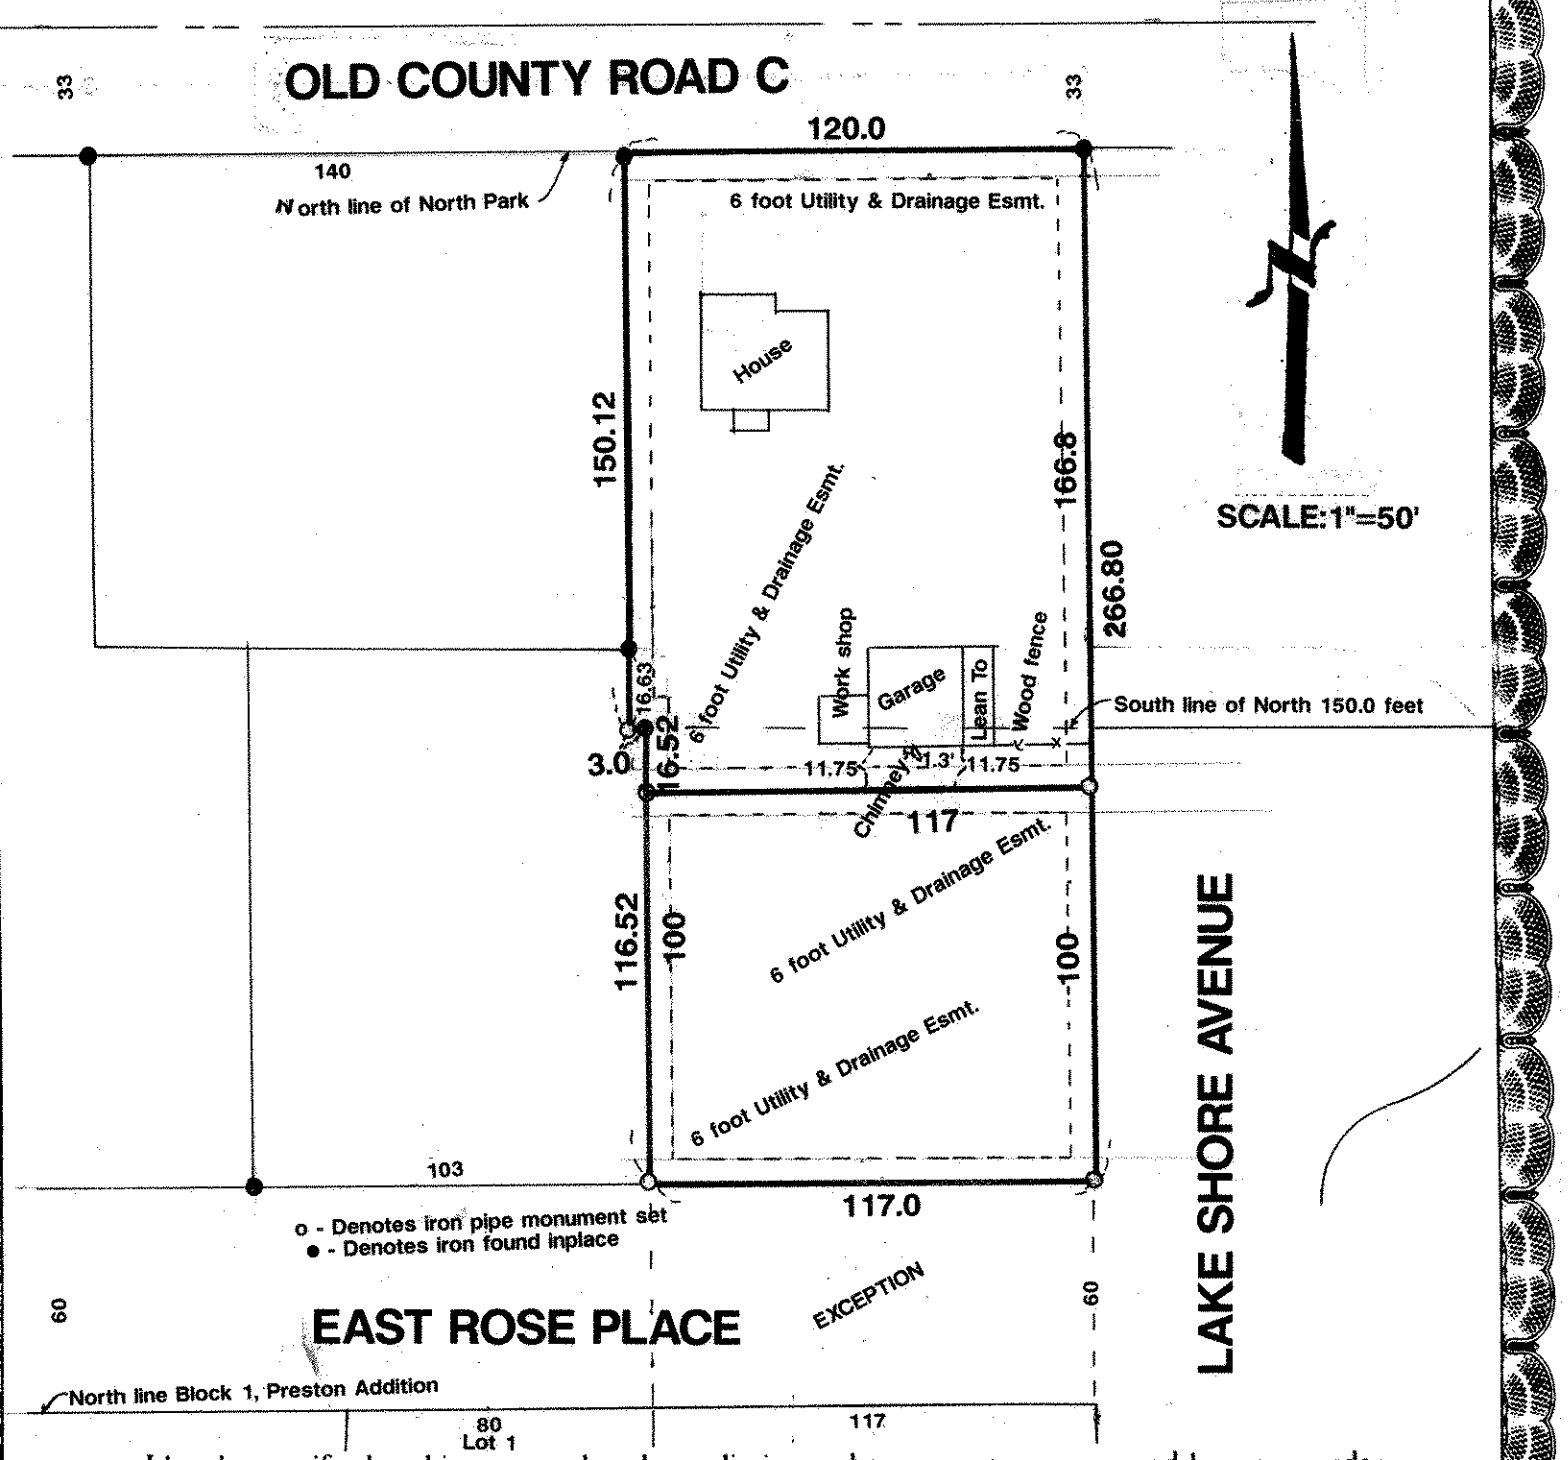

SCALE:1"=50'

I hereby certify that this survey, plan plat, preliminary plat or report was prepared by me or under my direct supervision and that I am a duly Registered Land Surveyor under the laws of the State of Minnesota.

Donald W. Schmidt

10459	7/21/93	931337	
Reg. No.	Date	Job No.	Book No.