

GOMSTOCK AND DAVIS INC.


3092 N. LEXINGTON AVE. ST. PAUL, MN. 55113 483-4408

AMERICAN HOME & CONSTRUCTION INC. (David Wright)

DESCRIPTION:

The East 77.0 feet of that part of Lots 32 and 33, Block 3, Gervais Heights which lies South of the North 21 feet of said Lot 33. Ramsey County, Minnesota.

ALLAN AVENUE

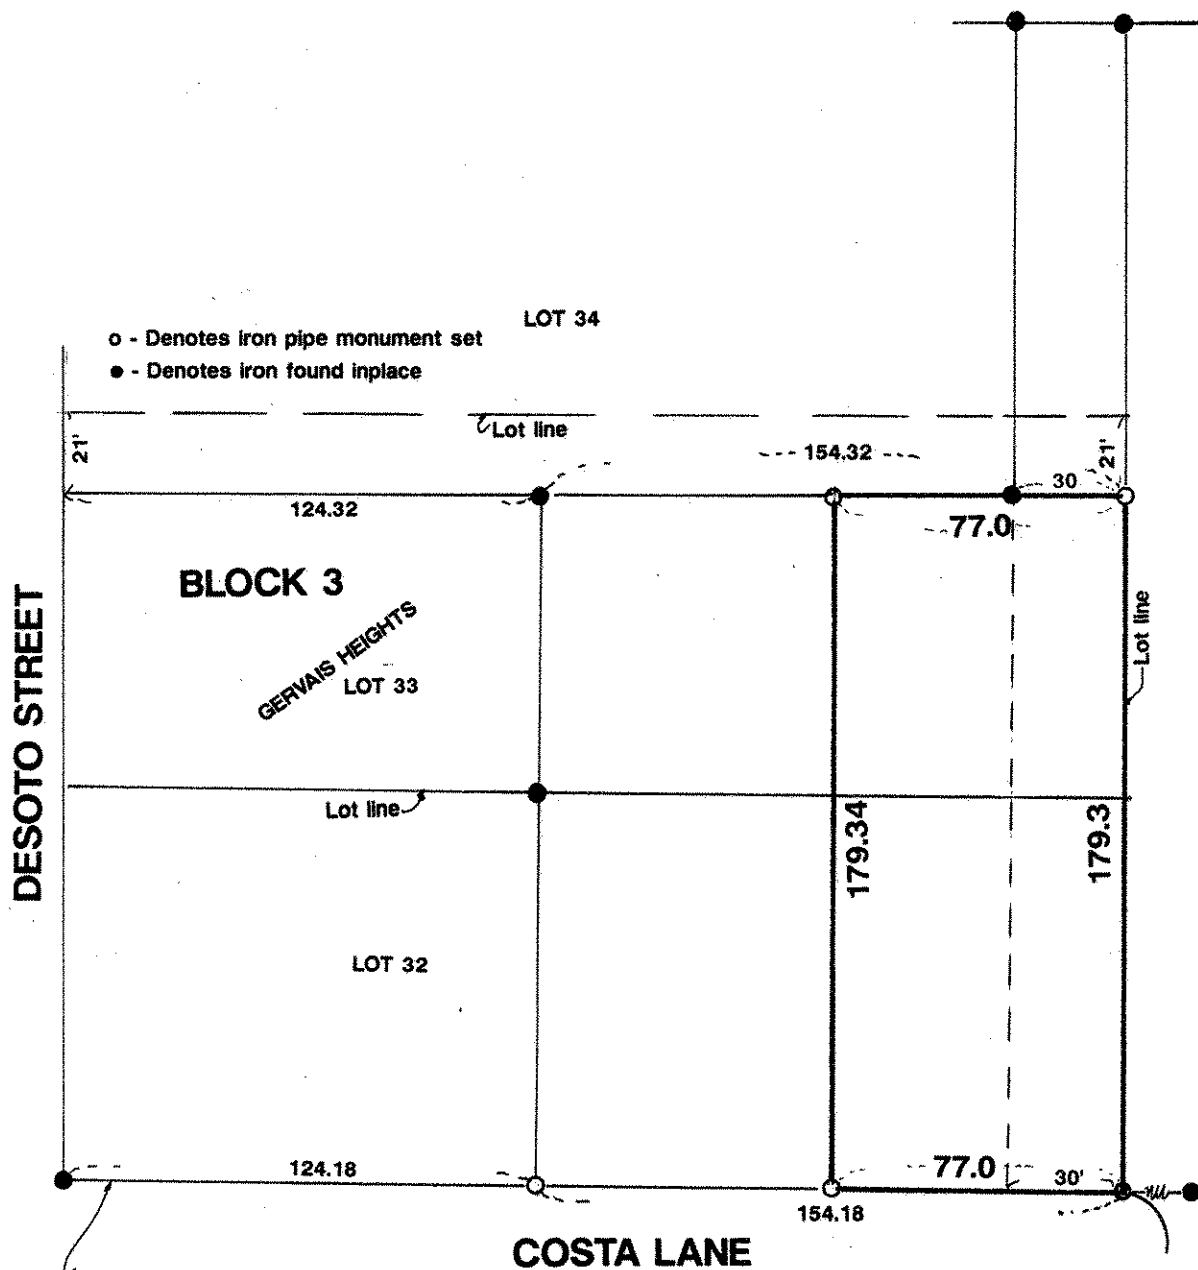

o - Denotes iron pipe monument set
● - Denotes iron found in place

SCALE: 1"=50'

COSTA LANE

North Line Costa Estates Third Addition as monumented

I hereby certify that this survey, plan plat, preliminary plat or report was prepared by me or under my direct supervision and that I am a duly Registered Land Surveyor under the laws of the State of Minnesota.

Donald Schmitt

10459
Reg. No.

4/22/93
Date

931282
Job No.

Book No.