


29-22

# COMSTOCK AND DAVIS INC.

3092 N. LEXINGTON AVE. ST. PAUL, MN. 55113 483-4408

SURVEYED FOR: Paul Widman

DESCRIPTION: Lot 3, Block 3, Westwinds, Ramsey County, Minnesota.

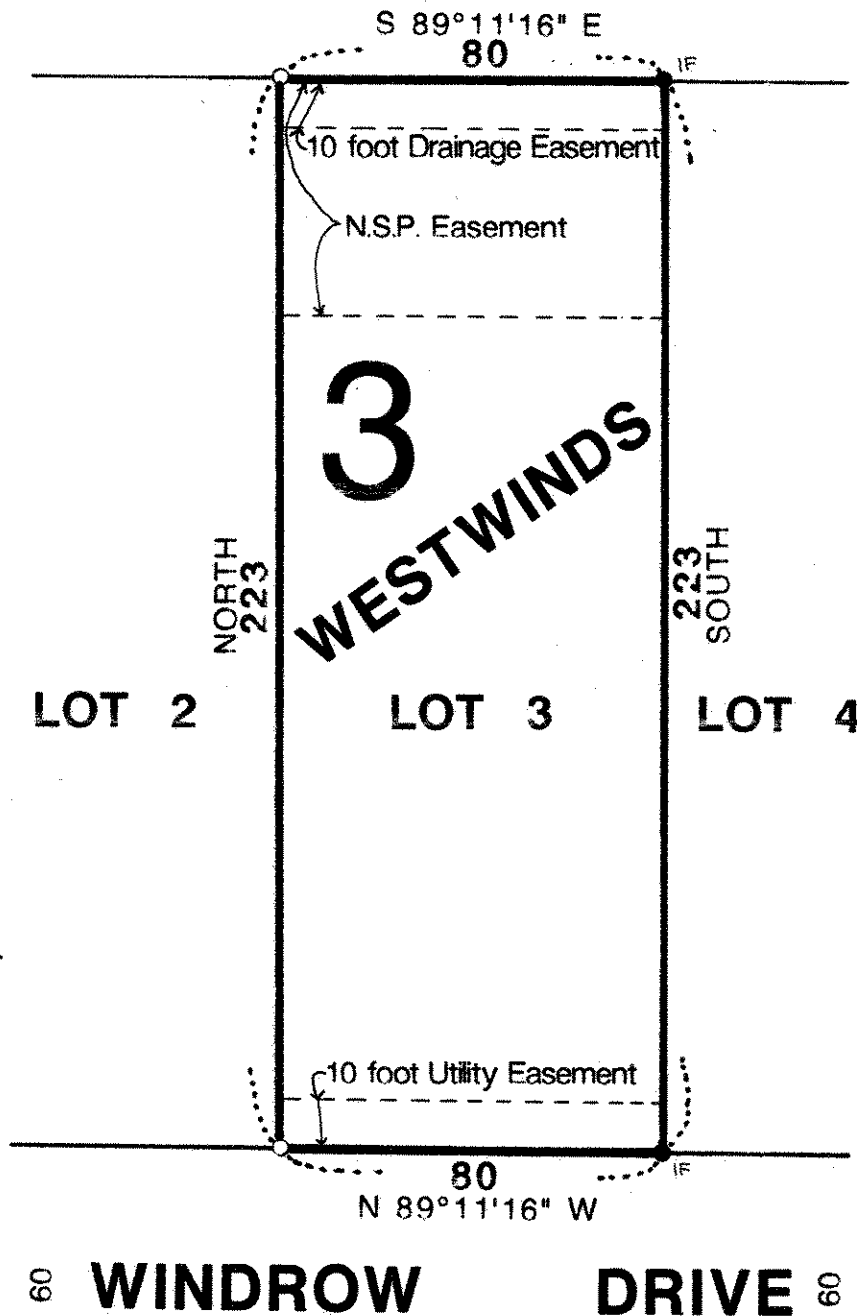

- <sub>IF</sub> Denotes Iron Pipe found.
  - Denotes Iron Pipe set and marked with Reg. No. 10459.
- Easements as per plat only are shown.

SCALE: 1"=40'

I hereby certify that this survey, plan plat, preliminary plat or report was prepared by me or under my direct supervision and that I am a duly Registered Land Surveyor under the laws of the State of Minnesota.

*Charles J. Schmid*  
Reg. No. 10459

5/15/92  
Date

R-92796  
Job No. Book No.