


29-22

GOMSTOCK AND DAVIS INC.

3092 N. LEXINGTON AVE. ST. PAUL, MN. 55113 483-4408

SURVEYED FOR: Paul Widman

DESCRIPTION: Lot 9, Block 3, Westwinds, Ramsey County, Minnesota.

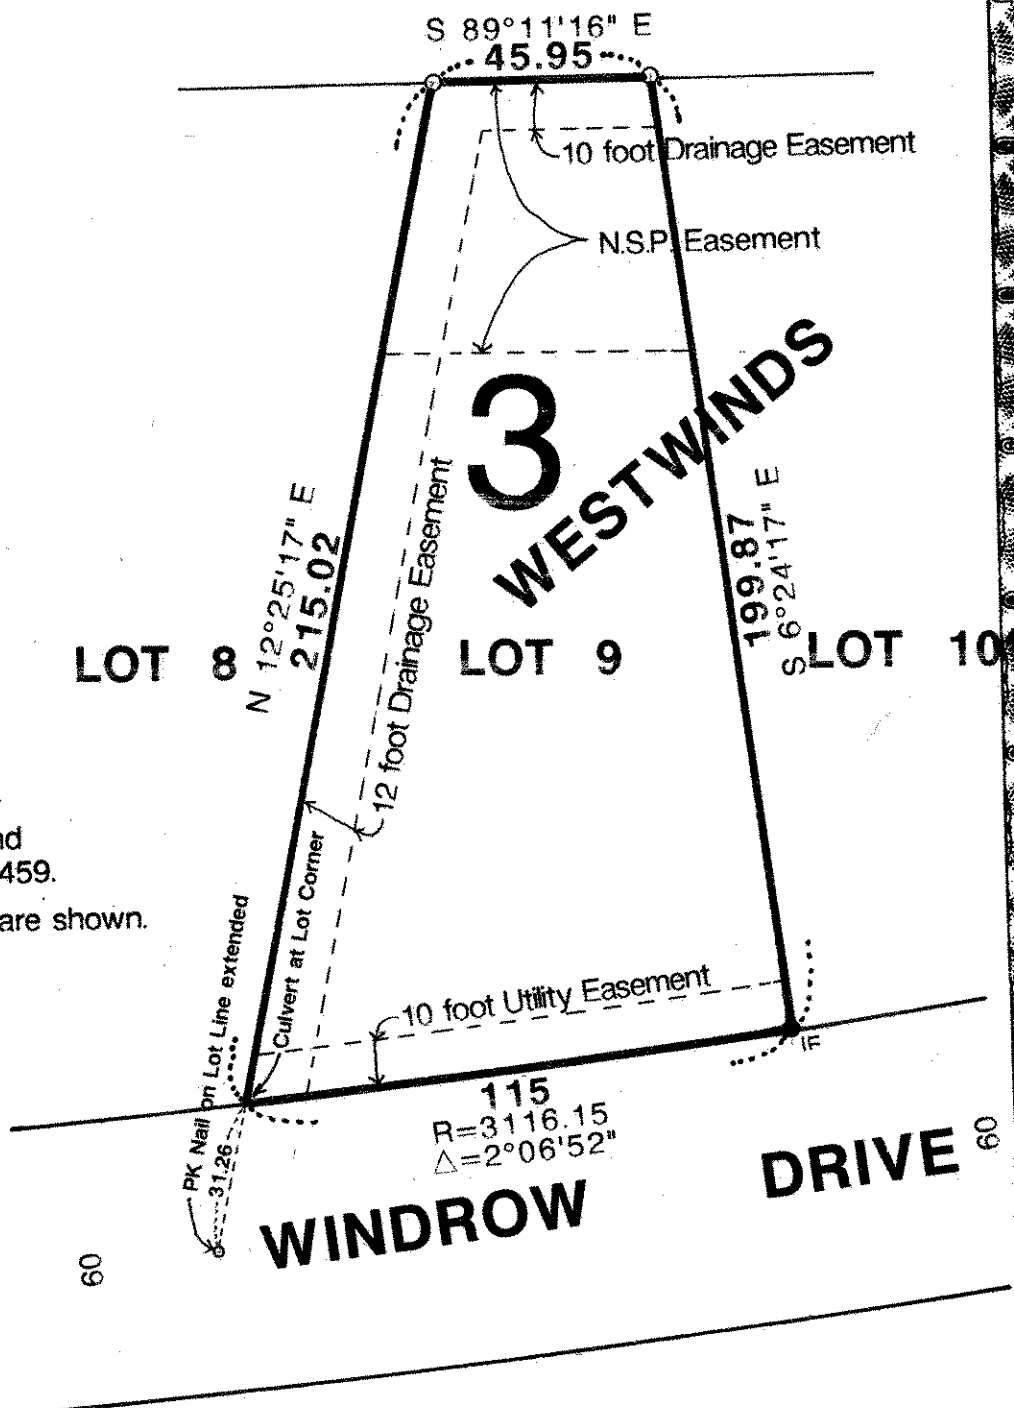

- IF Denotes Iron Pipe found.
 - Denotes Iron Pipe set and marked with Reg. No. 10459.
- Easements as per plat only are shown.

SCALE: 1"=40'

I hereby certify that this survey, plan plat, preliminary plat or report was prepared by me or under my direct supervision and that I am a duly Registered Land Surveyor under the laws of the State

of Minnesota
Paul A. Schmidt

10459	5/15/92	R-92796	
Reg. No.	Date	Job No.	Book No.