


LINDER CT.

107 101.07 100.00 HYD @ E.O. CUR-DE-SUR

100.00 HYD

BM 0.81

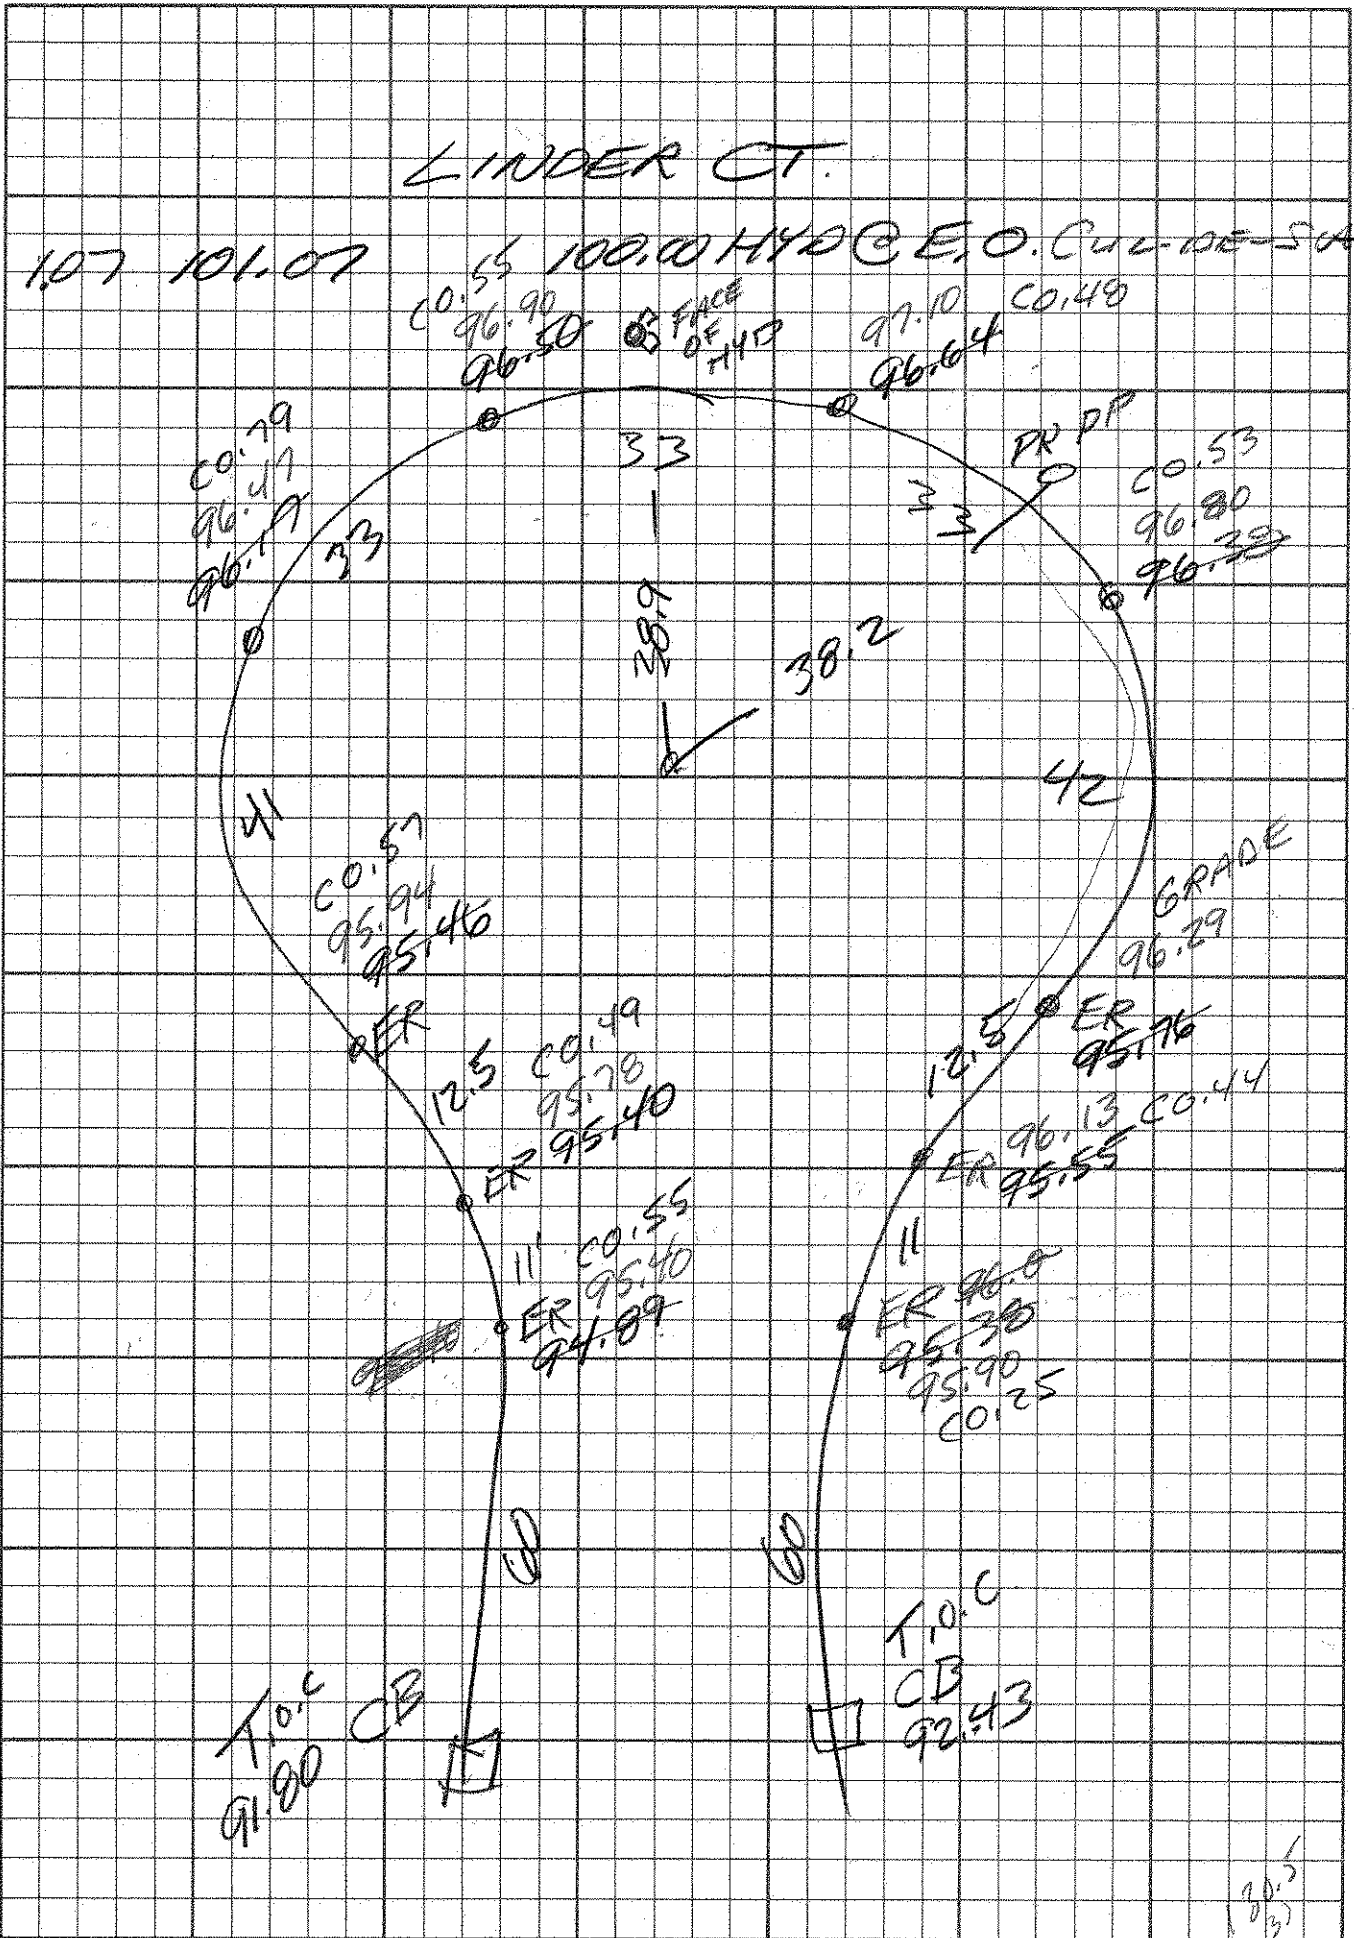

20.5
3)