


Flandrau

FOURTH

FIFTH

FREMONT

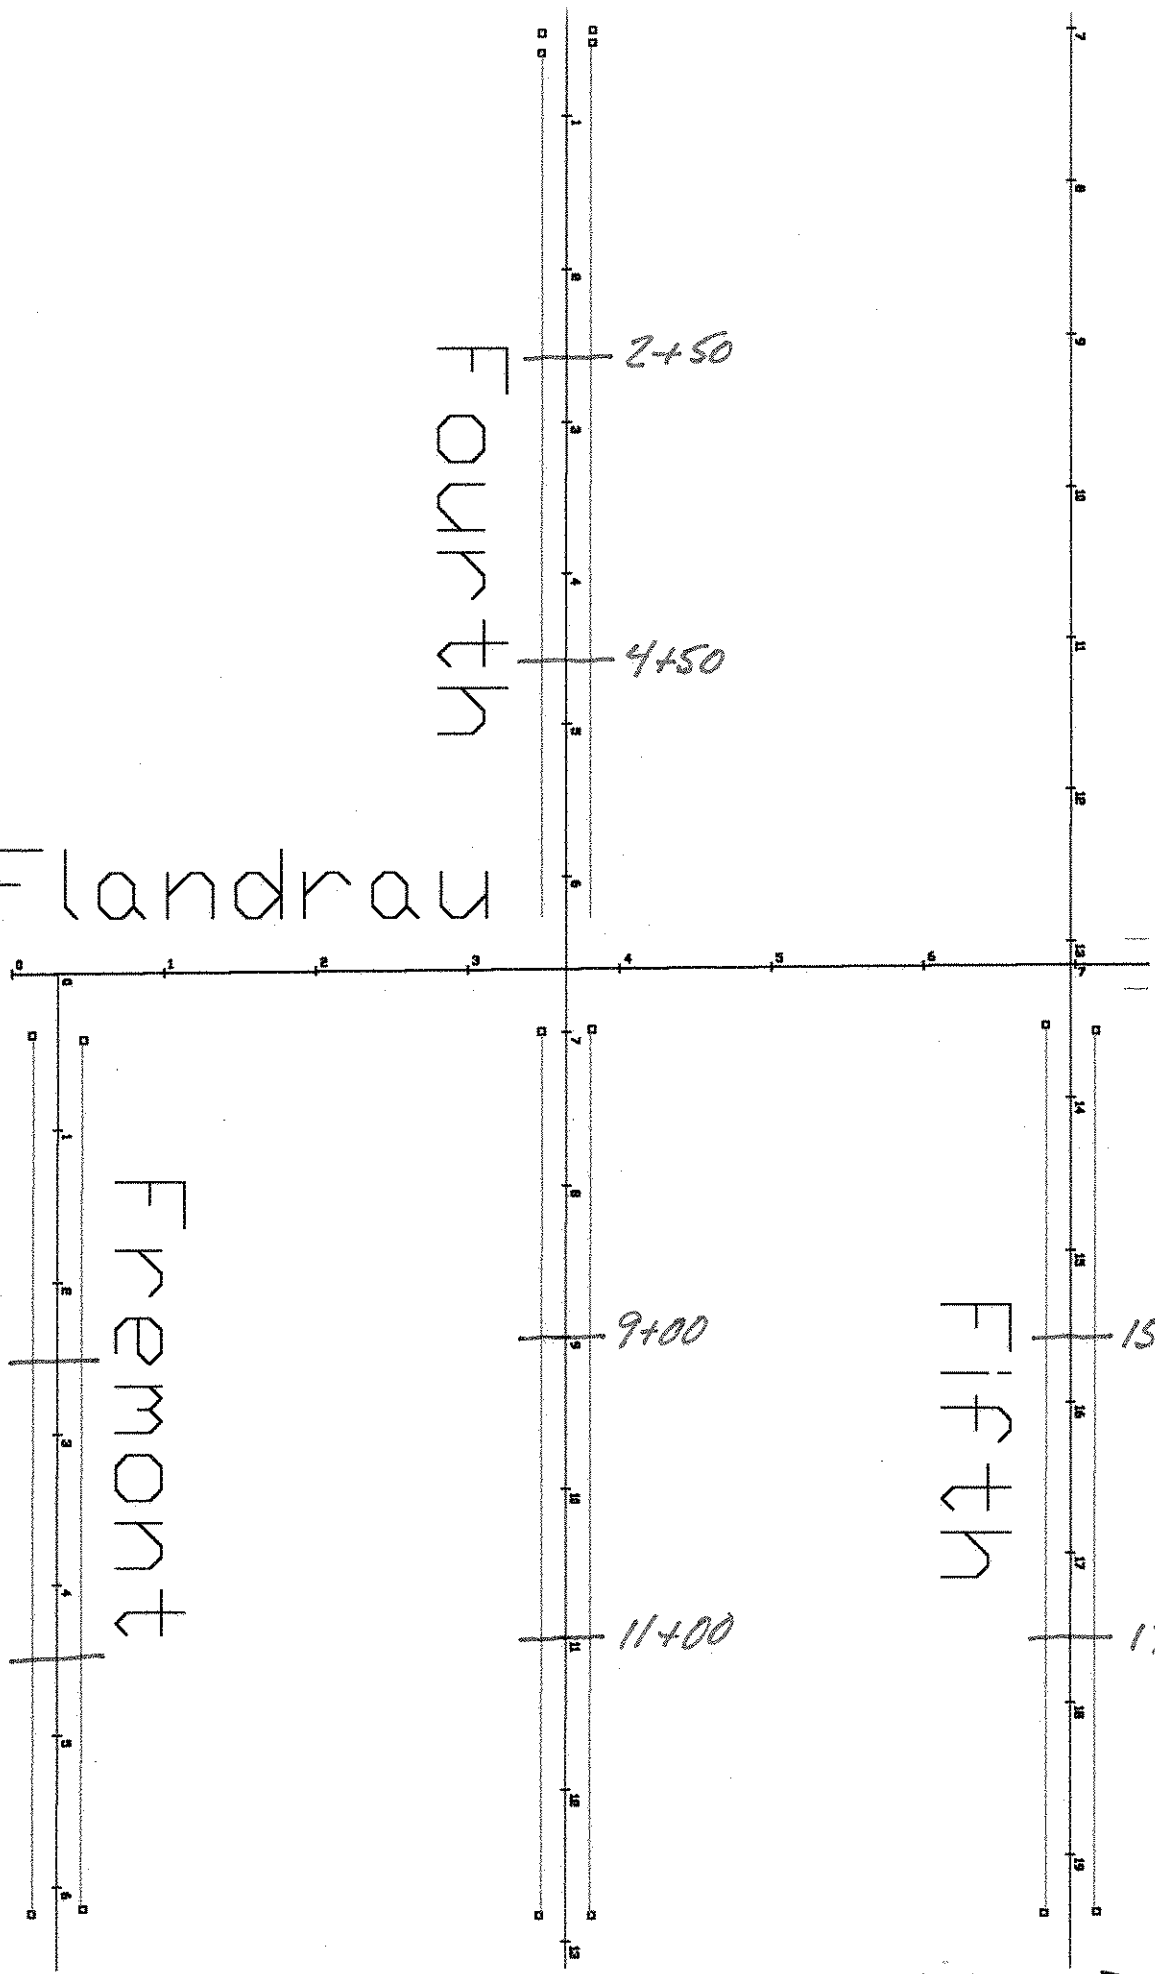

2+50

4+50

2+50

4+50

9+00

11+00

15+50

17+50

