


COMMON EXC SHOTS

LINE
EST INFORMATION
TUAL LOCATIONS
BEFORE
THE CONTRACTOR
FORE STARTING
IN THE VICINITY
ION 1507

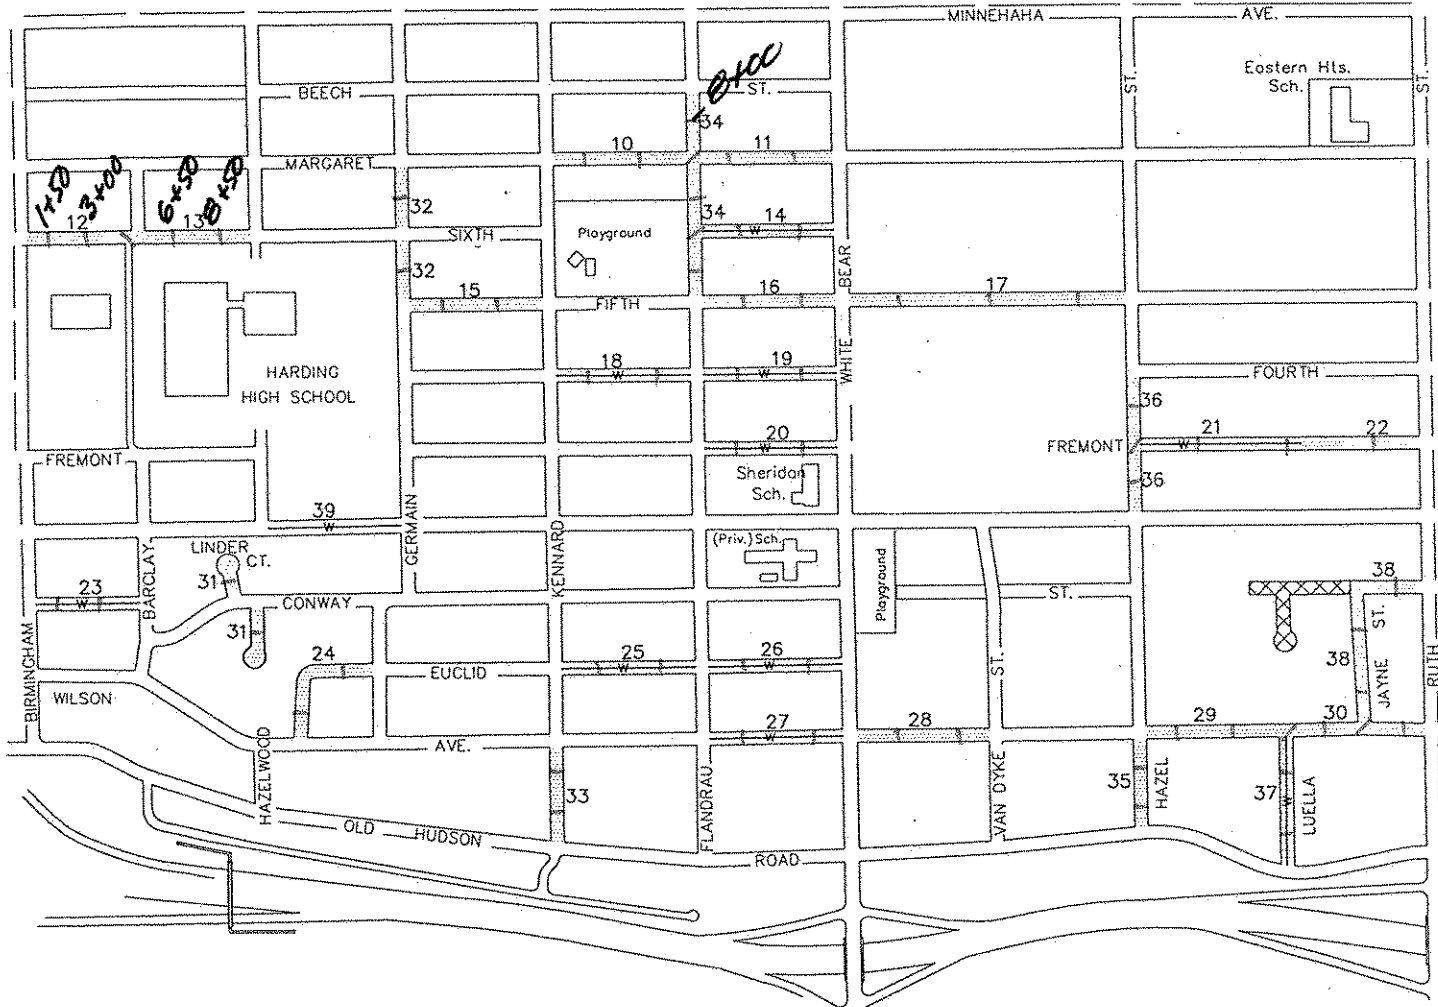

14

PLAN SHEET NUMBER
 STREET PAVING
 STREET PAVING &
 WATER MAIN REPLACEMENT

LEGEND LOCATION AREA MAP

CITY OF ST. PAUL, DEPARTMENT OF PUBLIC WORKS

KENNARD

PROJECT NUMBER:	01-P-8123	STATE AID PROJECT NUMBER	
DRAWER NUMBER:	12	CAD DRAWING NAME:	PROJECTS/CURRENT/FIFTHKENN/FK-LEGEND
DRAWING NUMBER:	1449	DATE:	2/27/01
		SHEET 2 OF 58 SHEETS	

