

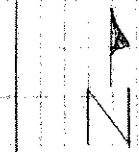


FB 1120

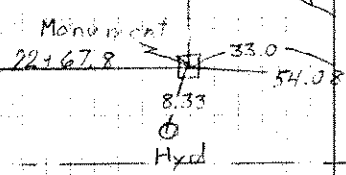

Geranium

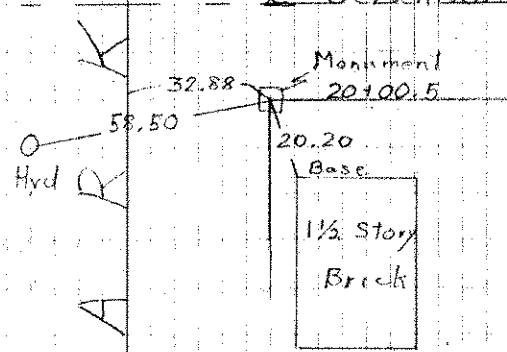

Jessamine