


FLANDRAU S.T.
 CONVEY TO MINNEAPOLIS
 11-5-46
 L.S.F.

Note Bacon's Add. (N. of 5th) puts E of
 Flandrau 1/2 way between W.B. + Kenwood
 Orig. Plat. of Lees Suburban (South
 of 5th St) puts E 1.5' West
 (2 way point.)

1-6-29
 3-13-17

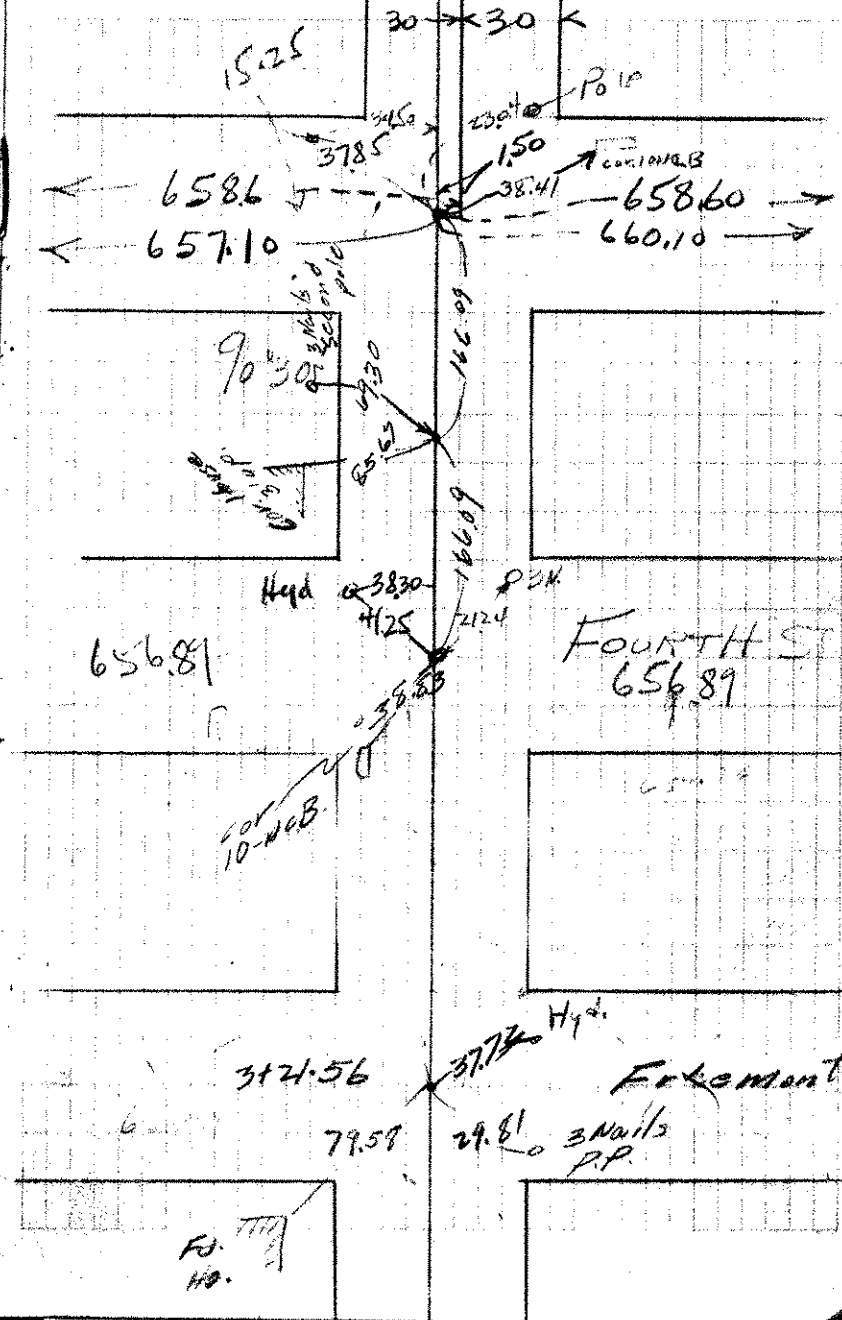

FB 1382