

49911
PRospect ~~49911~~

WARREN I. FORSBERG


2141
~~2000~~ E. 5th St.
St. Paul 6, Minn.

Registered Land Surveyor

PLAT OF SURVEY

OF PROPERTY OF Robert Simon
described as follows: The west 60.00' of Lot 5, Block 1,
Hudson Road Gardens, St. Paul, Minn.

Contract 87751857

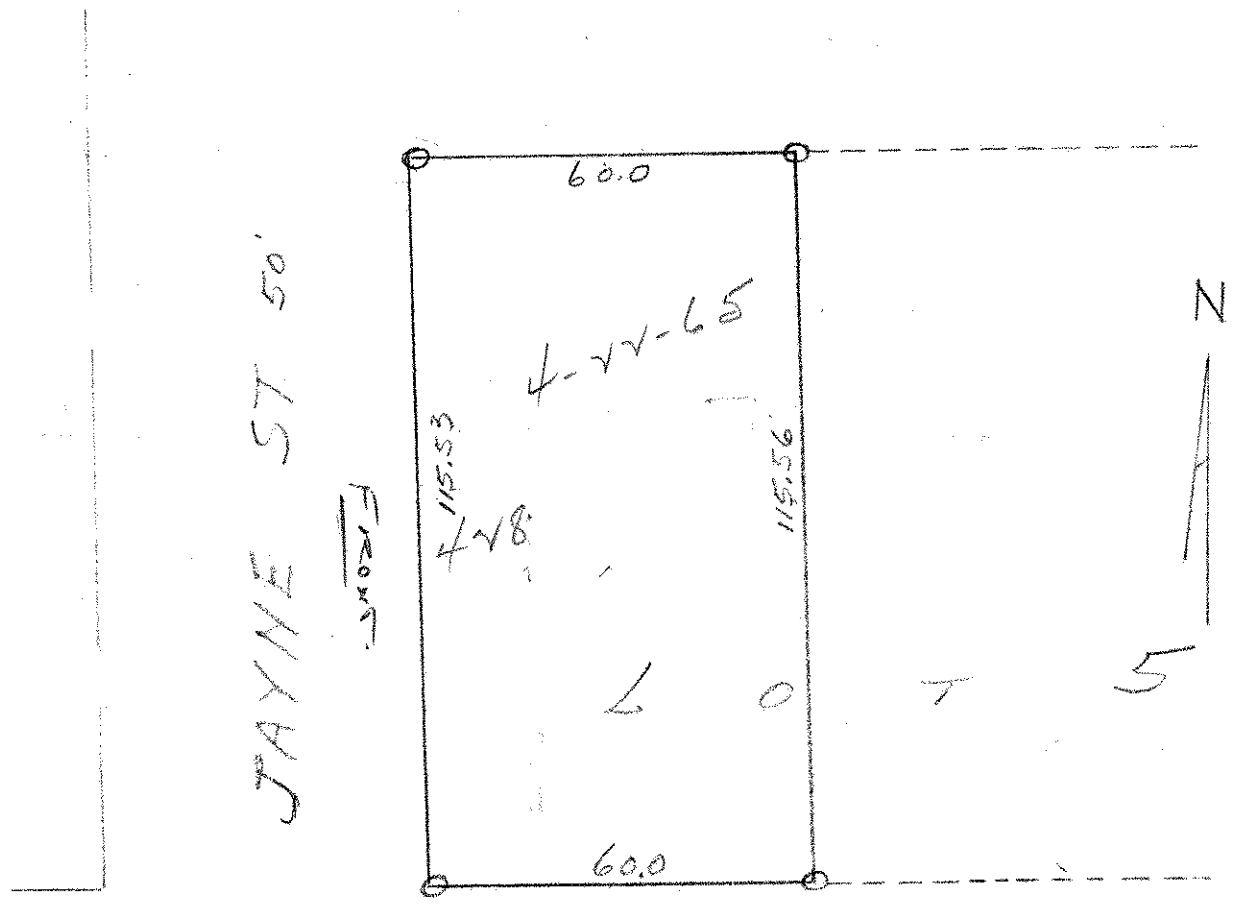

WILSON AVE 60'

CERTIFICATE OF SURVEY

I hereby certify that on May 17, 1962 I surveyed the property described above and that the above plat is a correct representation of said survey.

Scale: 1 inch 30 feet.
O—Indicates Iron Monument.

W. I. Forsberg