

49911  
PProspect ~~49911~~

# WARREN I. FORSBERG


2141  
~~2500~~ E. 5th St.  
St. Paul 6, Minn.

Registered Land Surveyor

## PLAT OF SURVEY

OF PROPERTY OF Robert Simon  
described as follows: The west 60.00' of Lot 5, Block 1,  
Hudson Road Gardens, St. Paul, Minn.

Contract 9775151

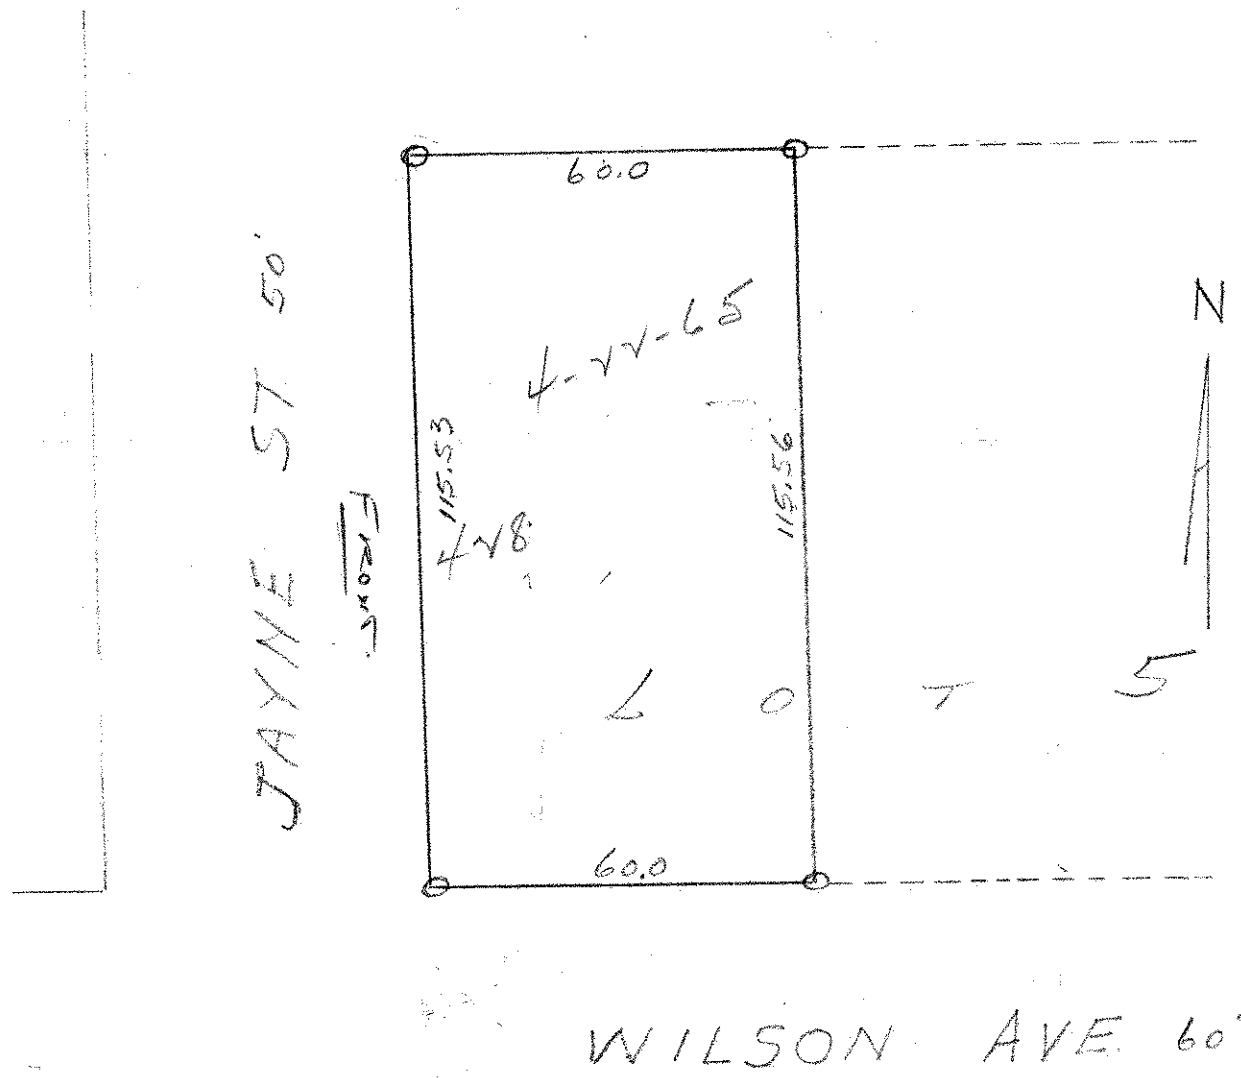

### CERTIFICATE OF SURVEY

I hereby certify that on May 17, 1962 I surveyed the property described above and that the above plat is a correct representation of said survey.

Scale: 1 inch 30 feet.  
O—Indicates Iron Monument.

*W. I. Forsberg*