

FB 1501A


transit tie

T-29 R-22

10-7-82

Cutting Graven - Ersted - Bimler 42

Mast Nesterly Cor. Kellogg Square APTS.

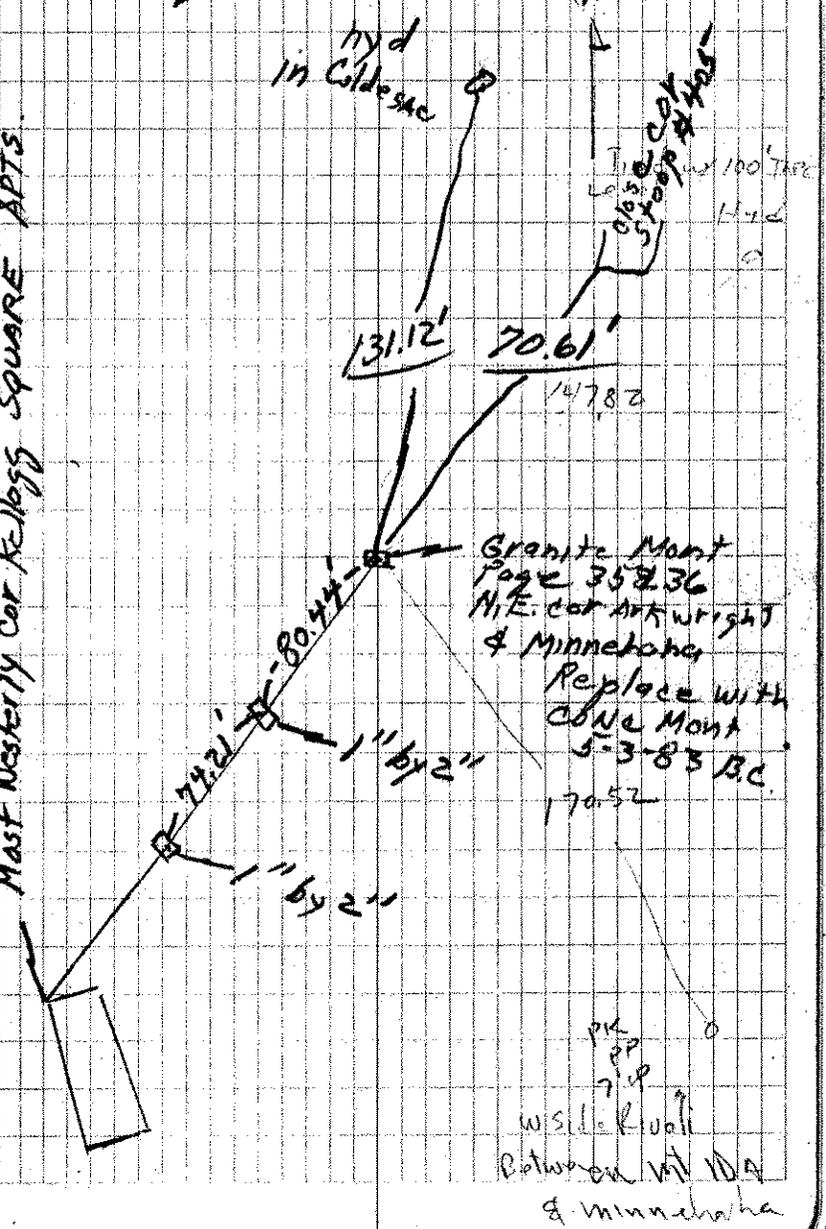

hyd  
in Coldsac

The close  
5' deep #405

100' TARE  
H-12  
9

131.12'

70.61'

147.82

Granite Mont  
Page 358.36  
N.E. cor. Ark Wright  
Replace with  
CONE Mont  
5-3-83 B.C.  
170.52

74.21'

80.44'

1" by 2"

1" by 2"

PK  
PP  
7' 1/2'  
Wisl. K. Wall  
Between Mt. Wa  
