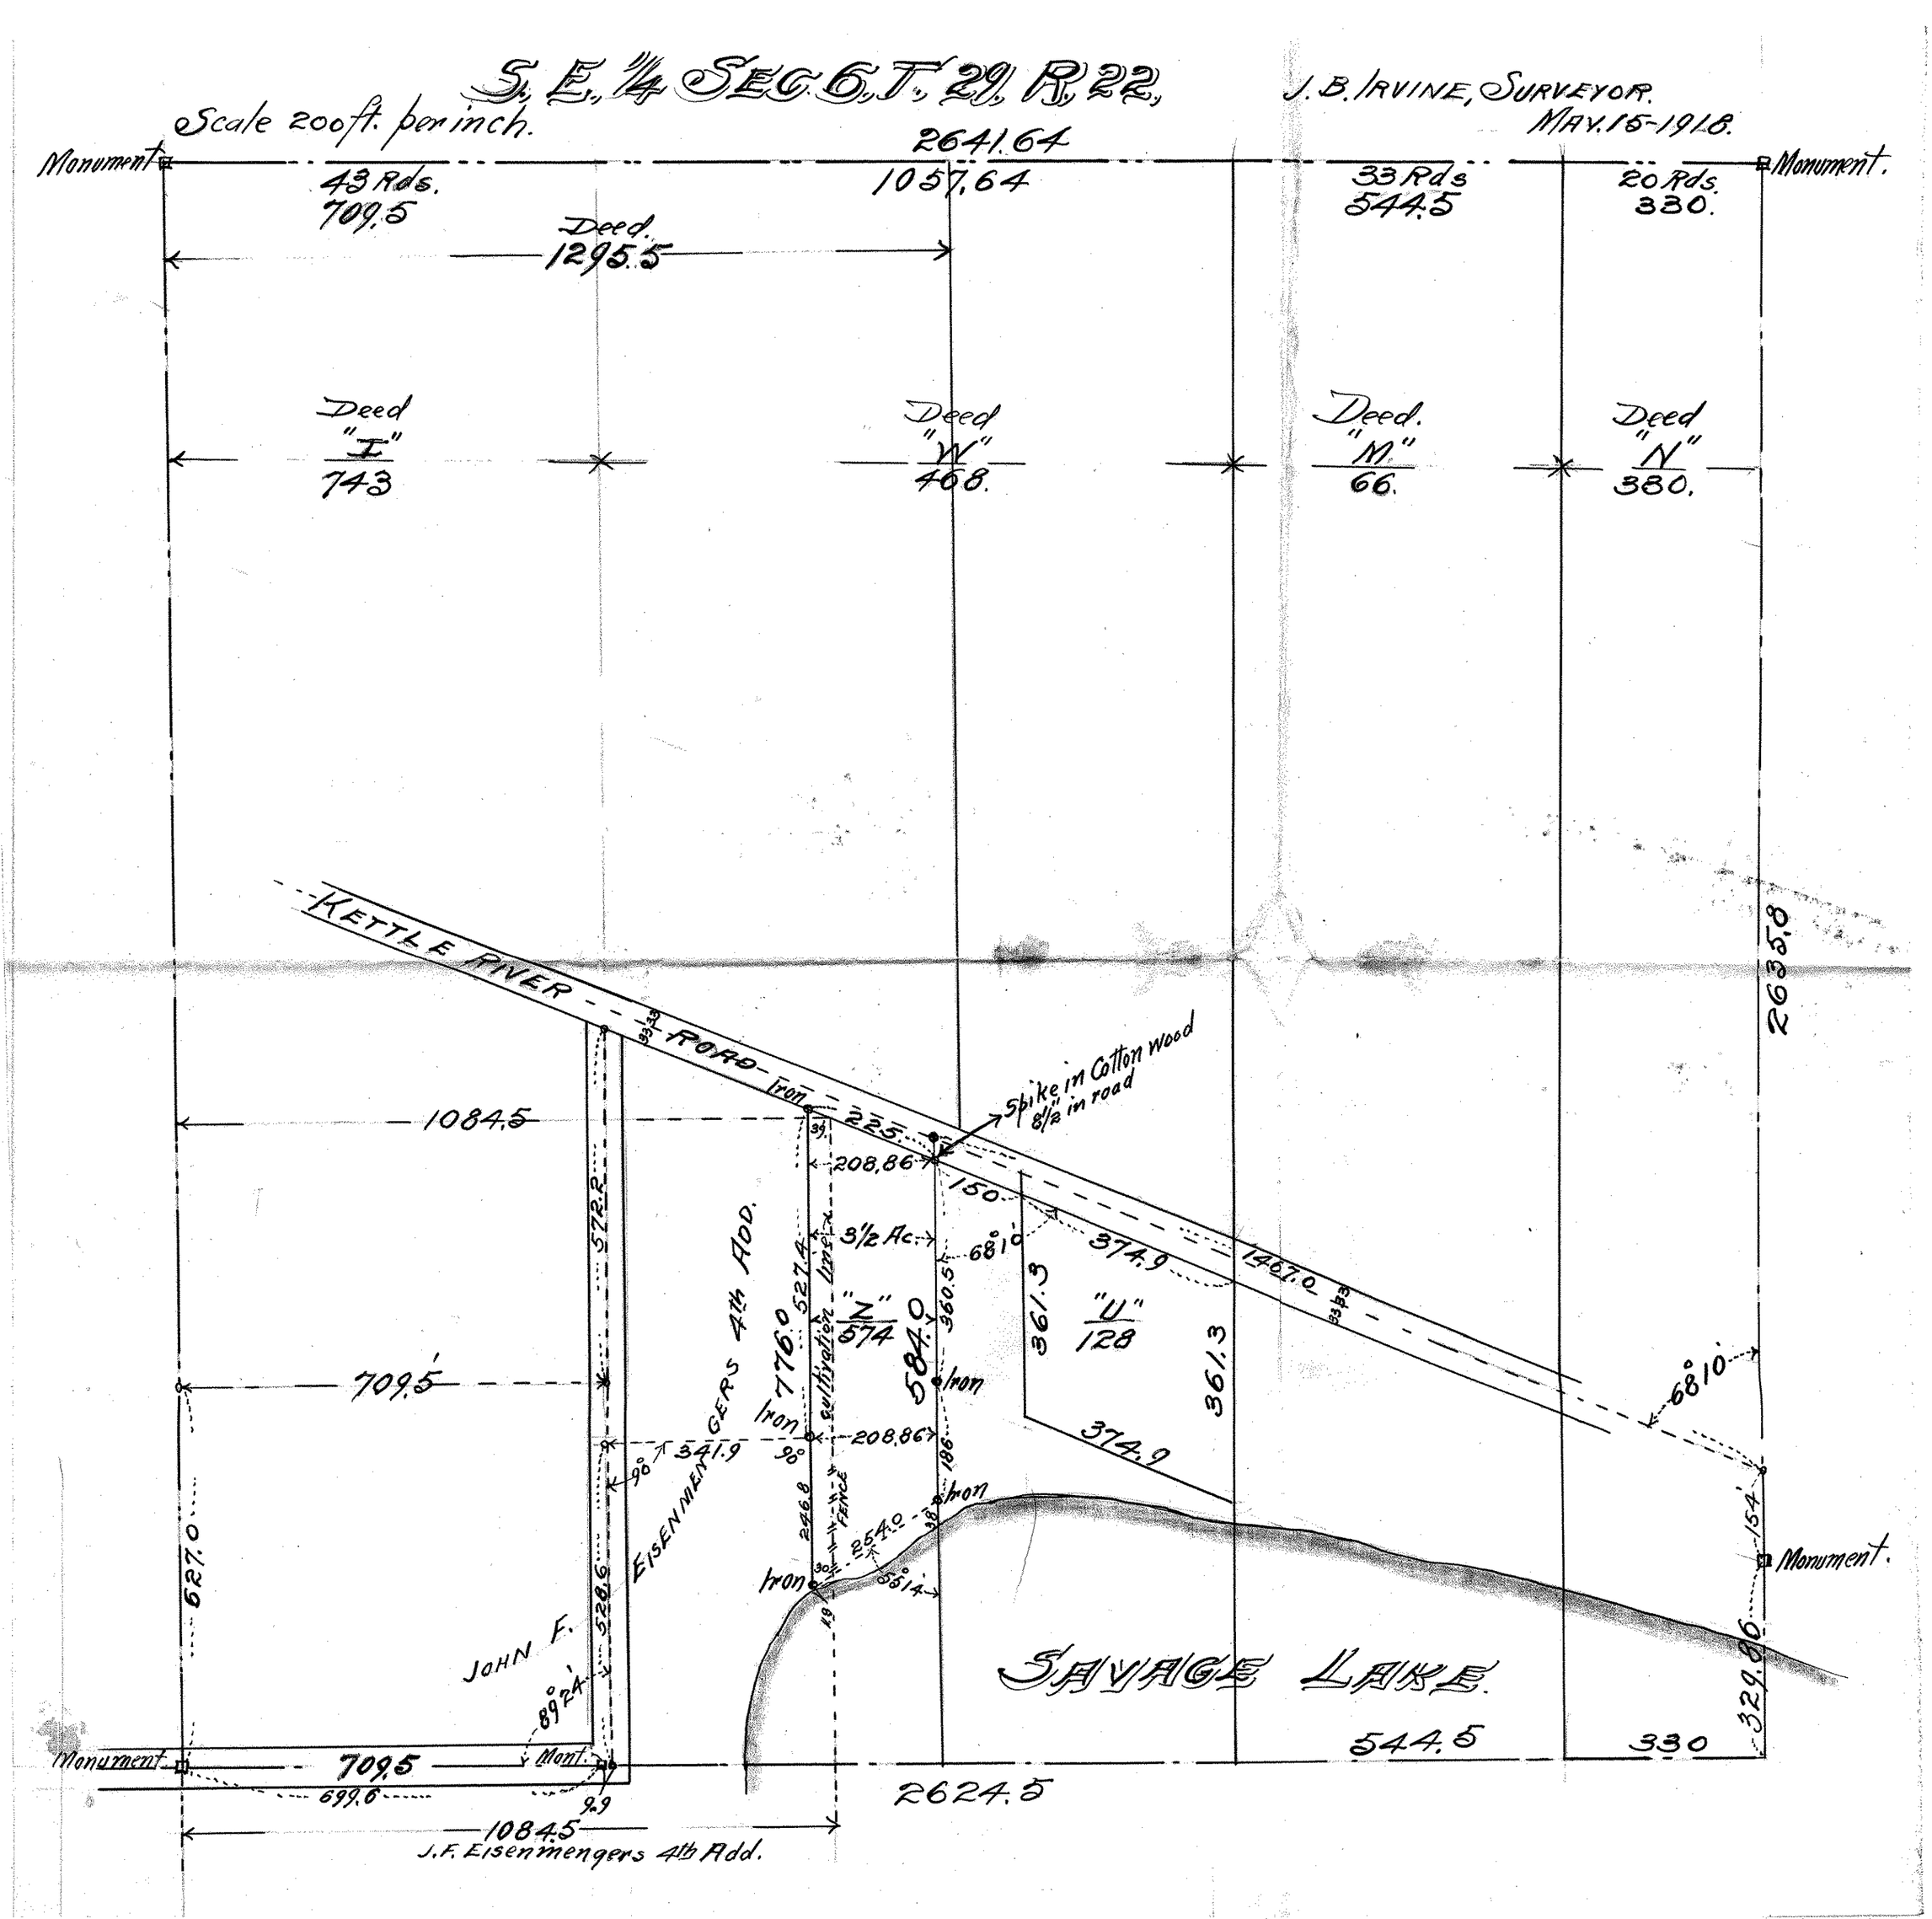
S. E. 1/4 SEC. 6. T. 29. R. 22.
J. B. IRVINE, SURVEYOR.
MAY. 15-1918.
Scale 200 ft. per inch.
Monument
Monument.
2641.64
1057.64
43 Rds.
709.5
33 Rds
544.5
20 Rds.
330.
Deed.
1295.5
Deed
"I"
743
Deed
"W"
468.
Deed.
"M"
66.
Deed
"N"
380.
KETTLE RIVER ROAD
Iron
225.
Spike in Cotton wood 8 1/2" in road
1084.5
208.86
150
3 1/2 Ac.
68°10'
374.9
1467.0
572.2
527.4
cultivation line
"Z"
574
584.0
360.5
361.3
"U"
128
361.3
709.5
776.0
Iron
208.86
374.9
68°10'
341.9
90°
186
246.8
FENCE
254.0
38
Iron
Iron
55°14'
154
Monument.
627.0
528.6
JOHN F.
89°24'
SAVAGE LAKE
329.86
544.5
330
Monument
709.5
Mont.
699.6
9.9
2624.5
1084.5
J. F. Eisenmengers 4th Add.
2635.8