


1-29-22

NOT RECORDED

TUT'S GARDEN TRACTS

SUB. OF NW 1/4-NW 1/4, SEC. 1, T. 29-N, R. 22-W

Scale - 200' = 1" (44.20 acres)

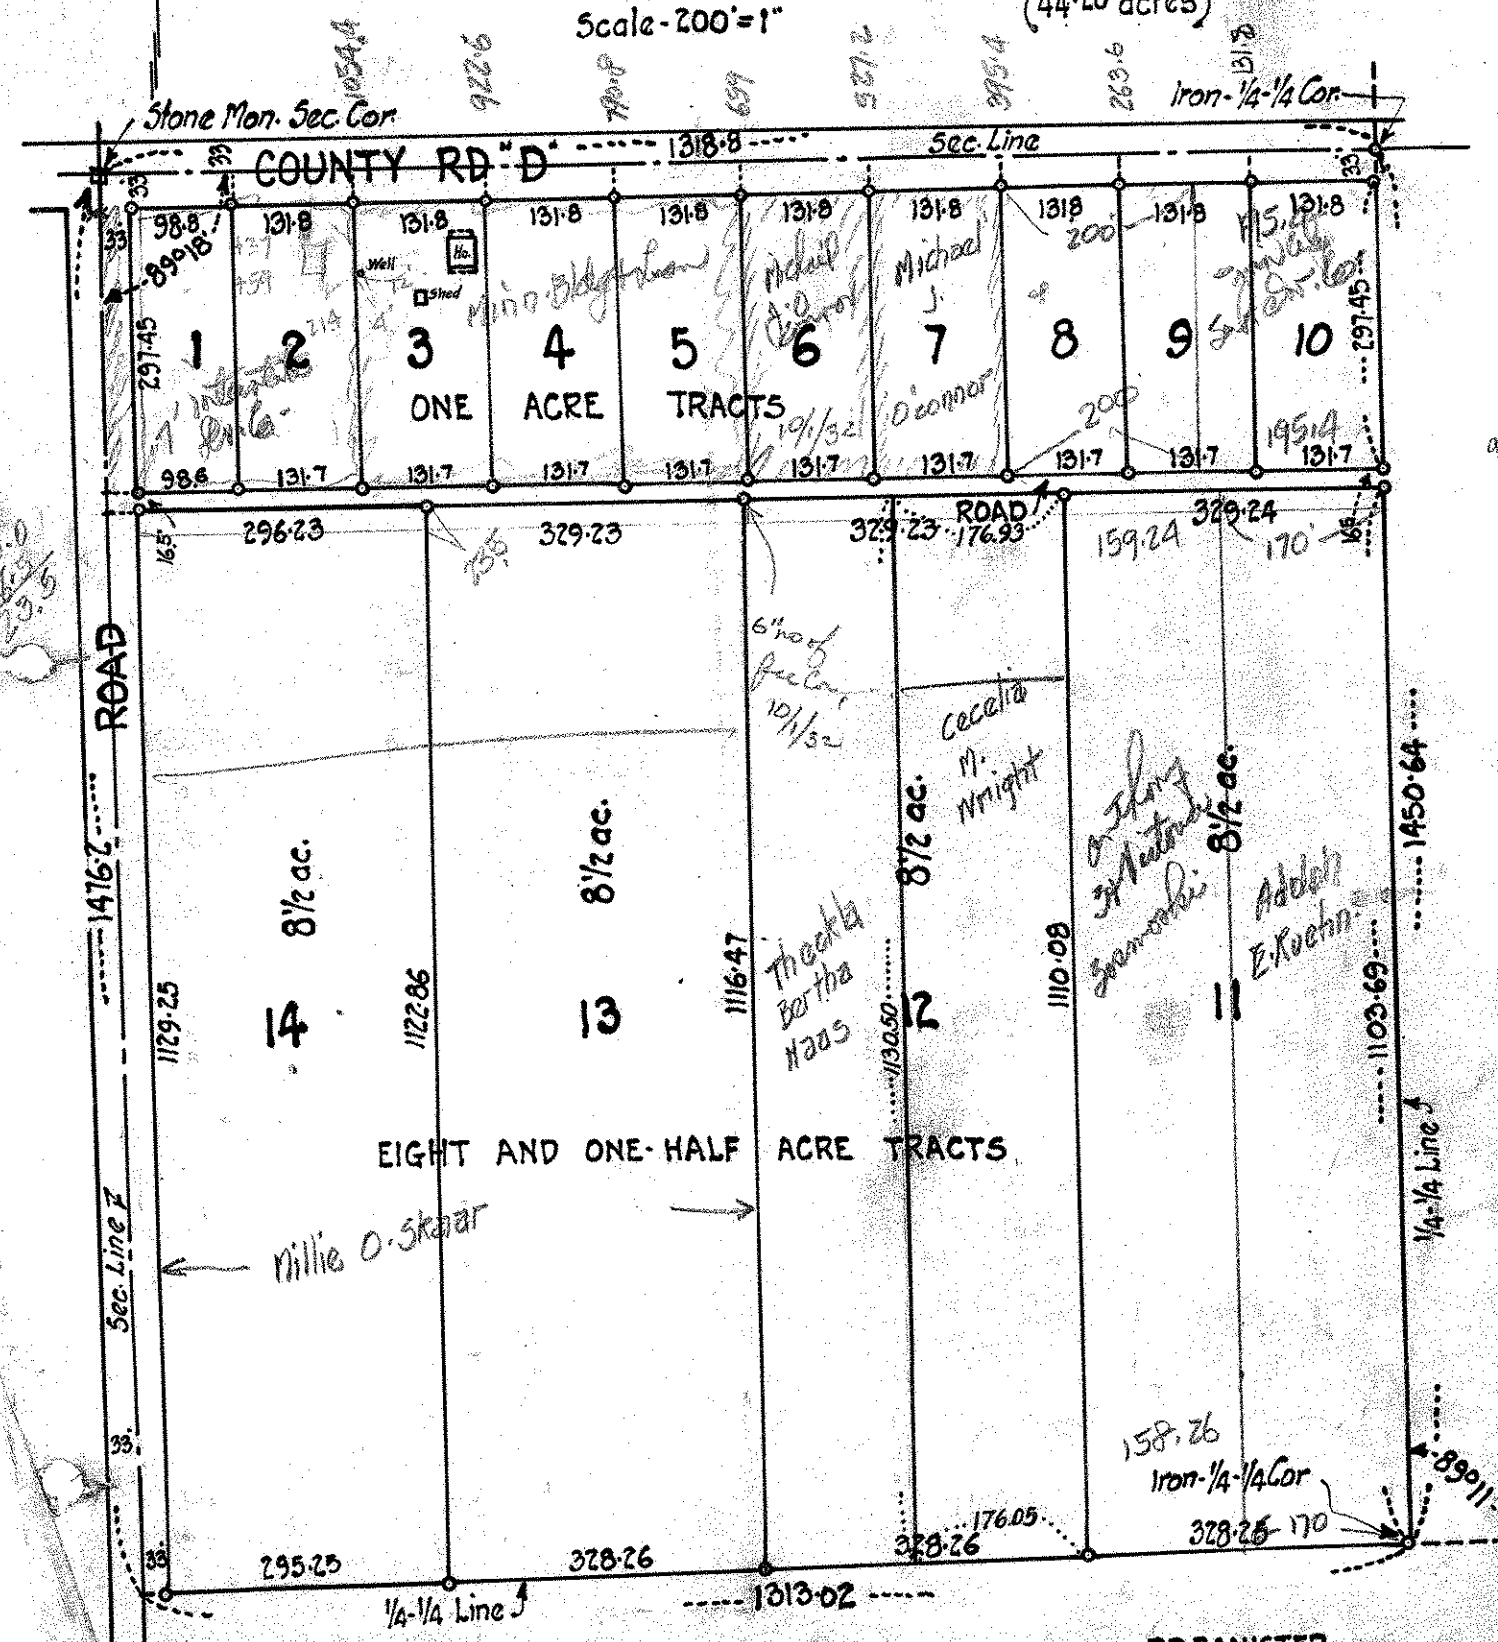

o-IRON MONUMENTS

Surveyed July 31-1924

PR. BANISTER
Civil Engineer

St. Paul, Minn.