THE E.½ N.W.¼, S.E.¼, S.W.¼ AND E.½ N.E.¼ S.E.¼ S.W.¼ AND THE WEST ½ OF THE N.E.¼ OF THE S.E.¼ OF THE S.W.¼ OF SECTION 21. TOWN 29 NORTH OF RANGE 22. WEST.
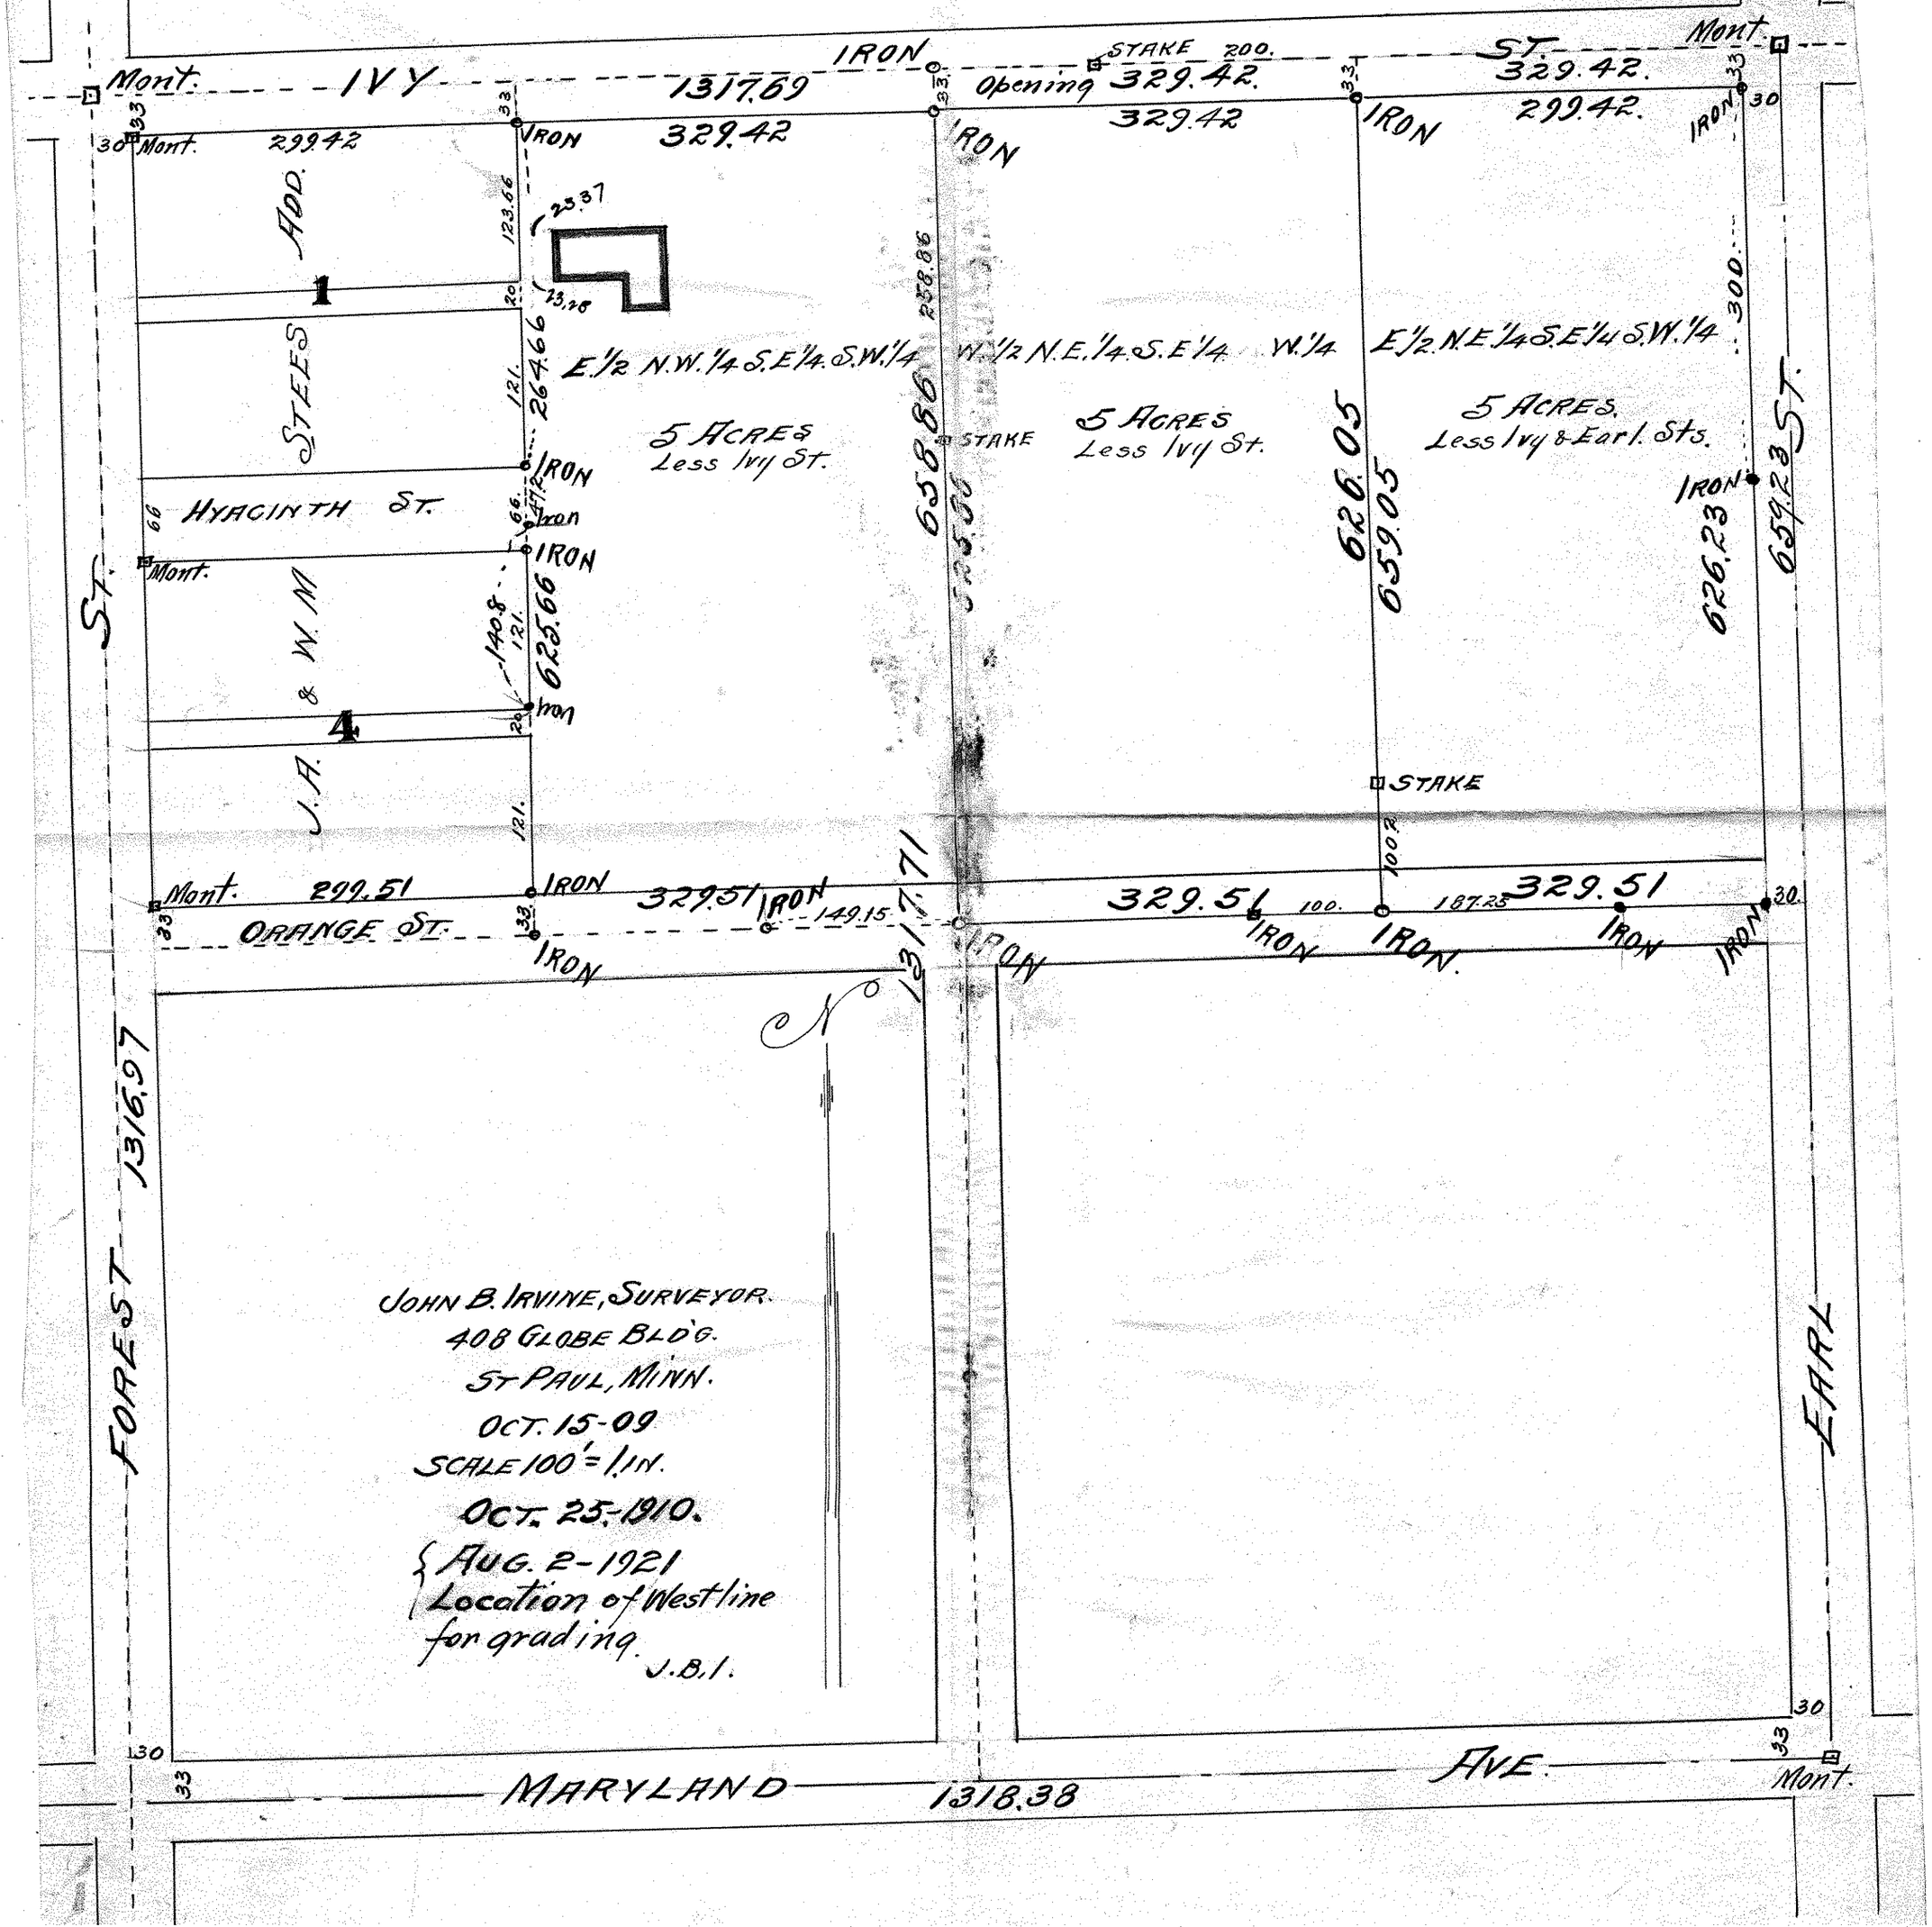
SUBJECT TO THE PUBLIC EASEMENT IN AND TO ANY STREETS, ROADS OR ALLEYS ON SAID PREMISES.