
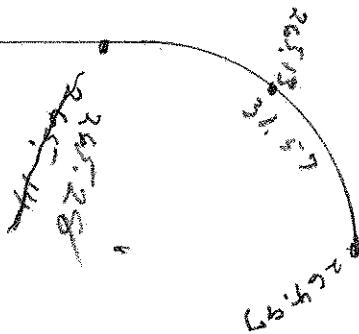


JAYNE

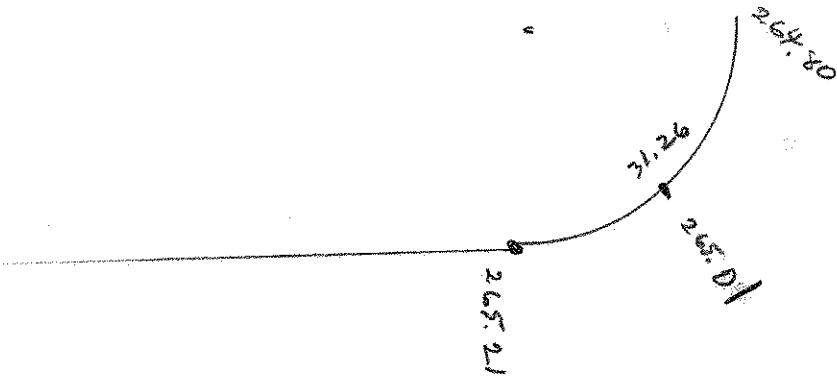

CONWAY