T29 R22
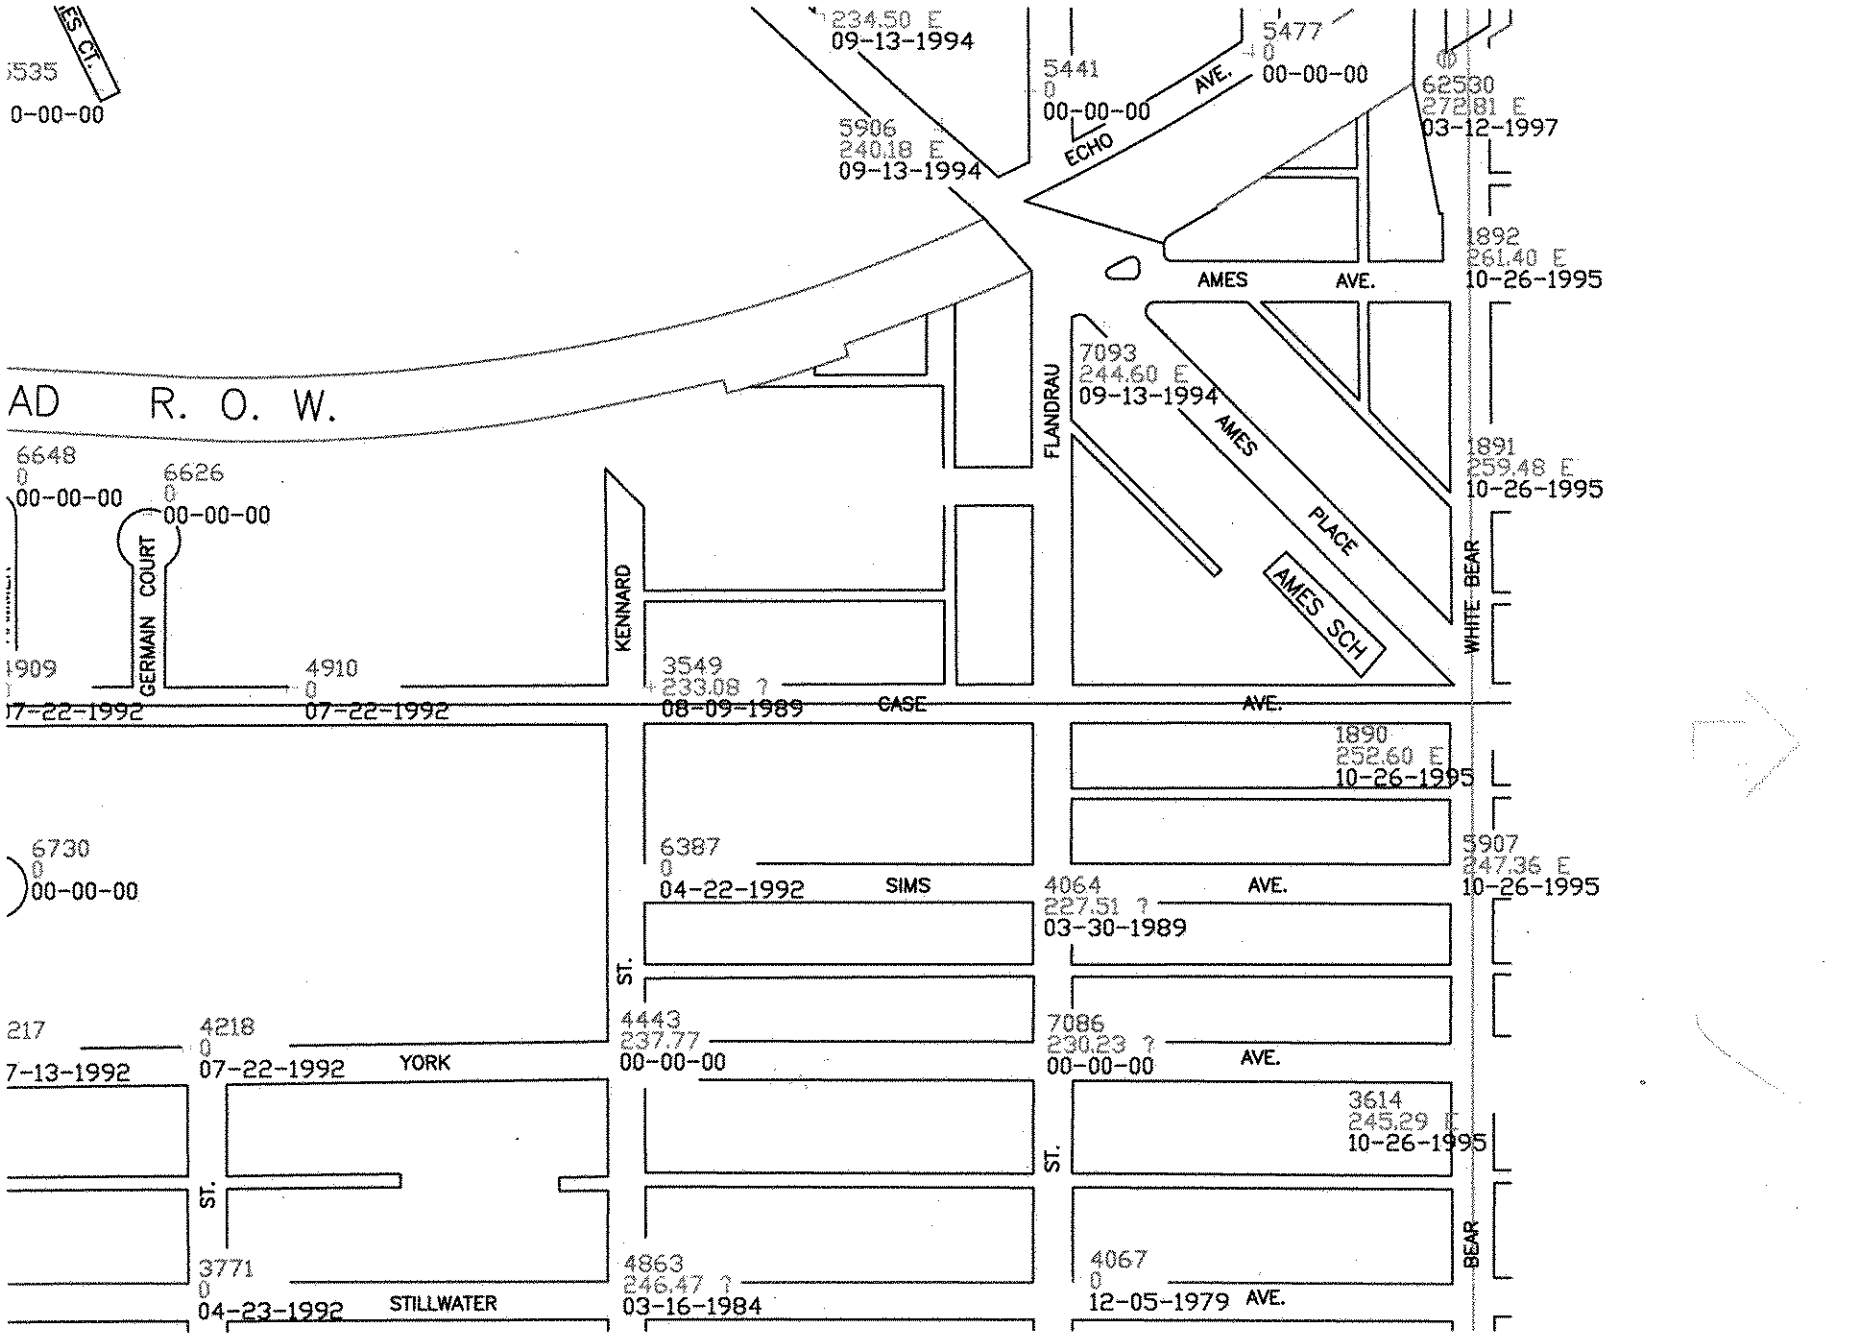
KENNARD & LACROSSE