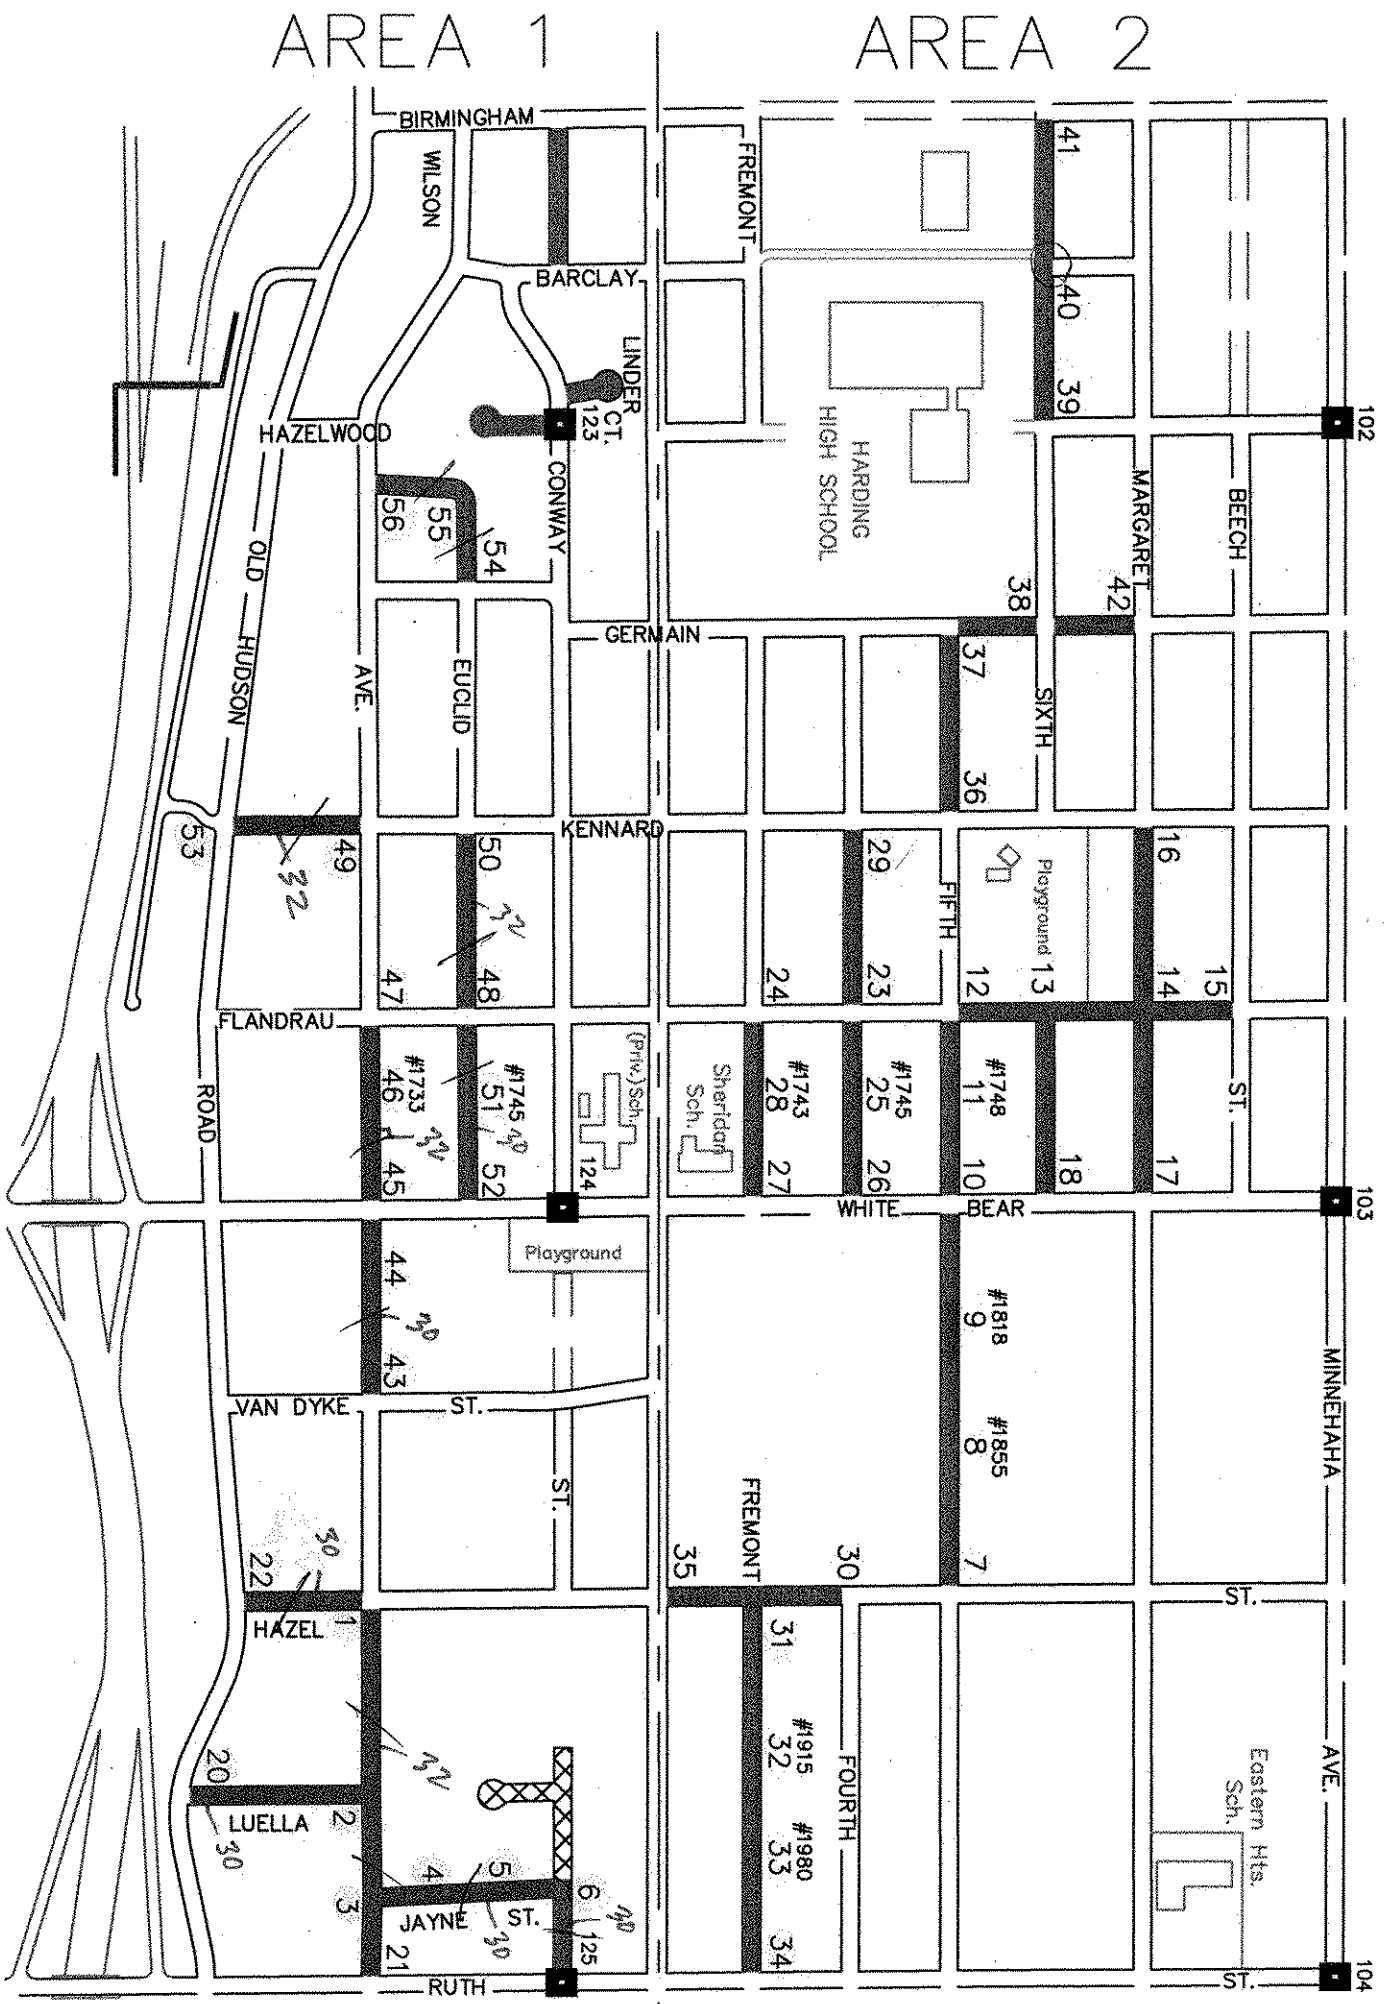
AREA 1
AREA 2
BIRMINGHAM
WILSON
BARCLAY
LINDER
CT.
123
HAZELWOOD
CONWAY
OLD HUDSON ROAD
AVE.
EUCLID
GERMAIN
KENNARD
FLANDRAU
VAN DYKE
ST.
HAZEL
LUELLA
JAYNE
ST.
RUTH
FREMONT
HARDING HIGH SCHOOL
MARGARET
BEECH
SIXTH
FIFTH
Playground
Sheridan Sch.
(Priv.) Sch.
124
WHITE BEAR
AVE.
MINNEHAHA
ST.
FREMONT
FOURTH
Eastern Hts. Sch.
ST.
102
103
104
#1733
#1745
#1743
#1748
#1818
#1855
#1915
#980