35 29 23

SURVEY OF Buel & Mackubins

Ramsey Co.

Part of Lots 9 and 10 Buel & Mackubin's Outlots.

Scale 1 inch = 50 feet.
O Indicates Iron.
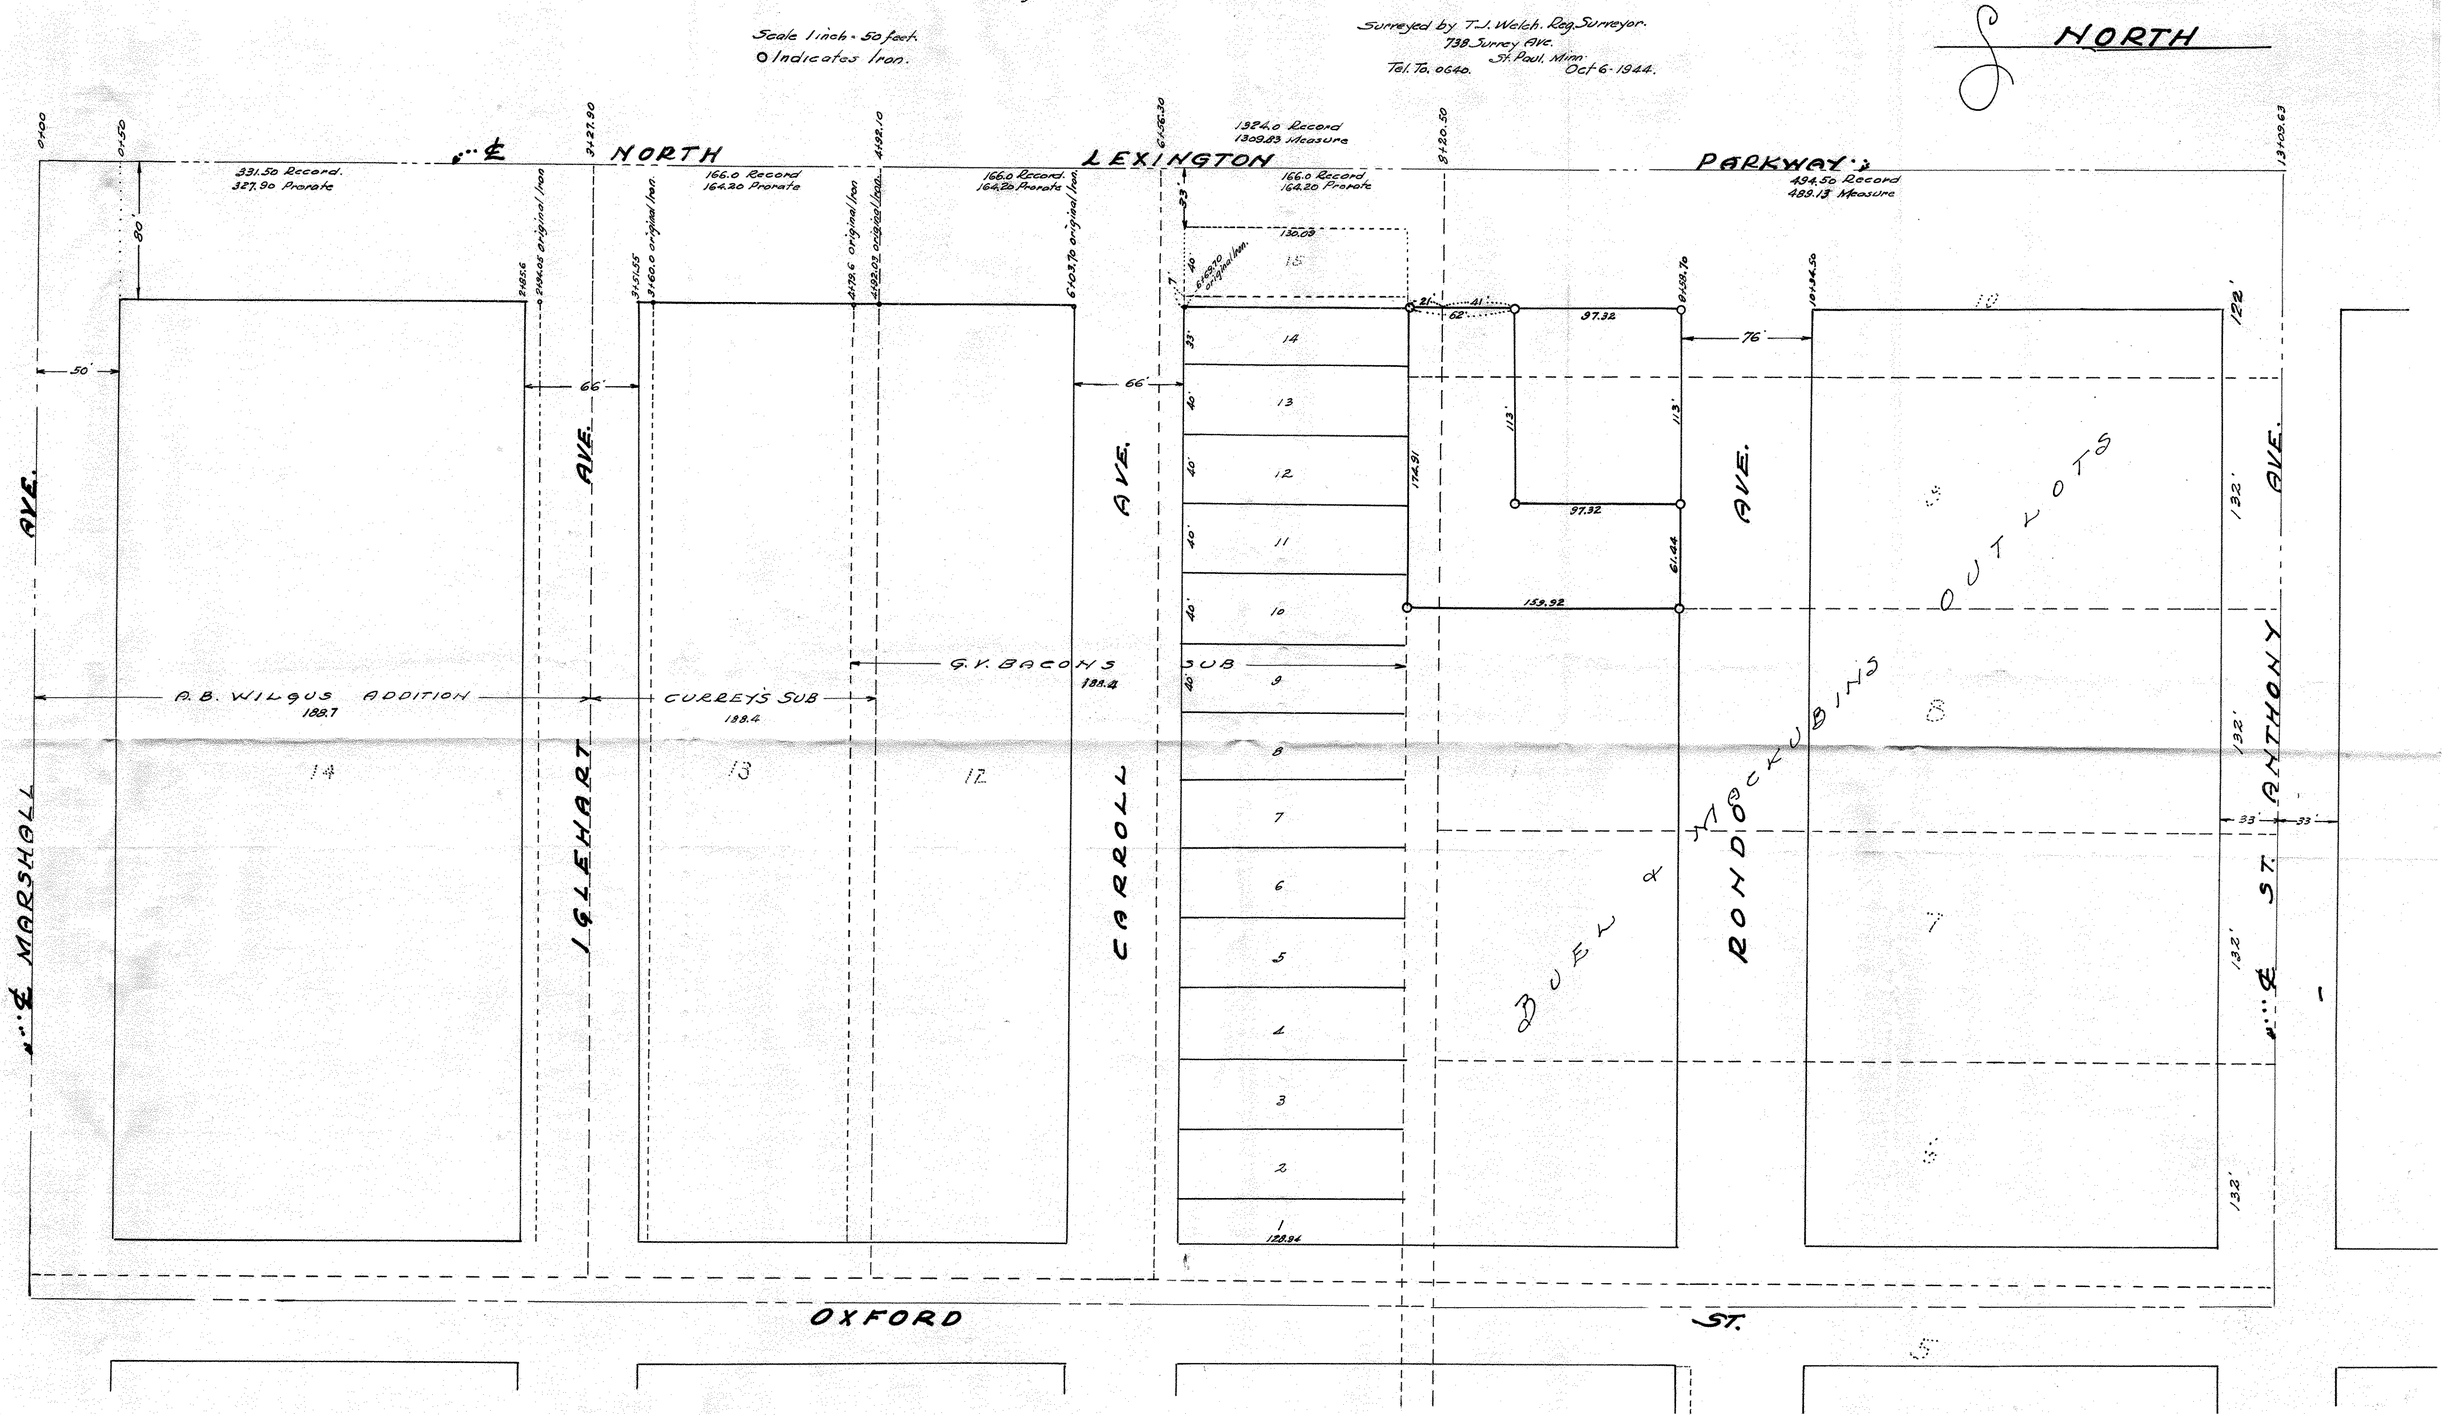
Surveyed by T. J. Welch. Reg. Surveyor.
738 Surrey Ave.
St. Paul, Minn.
Tel. To. 0640. Oct 6 - 1944.