COMSTOCK AND DAVIS INC.

3092 N. LEXINGTON AVE. ST. PAUL, MN. 55113 483-4408

SURVEYED FOR: Mary Francis Johnson DESCRIPTION: All of the West 3


All of the West 353 feet of the following described premises located in Section 2, Township 29, Range 23, Ramsey County, Minnesota; Beginning 266 feet North of the Southwest corner of the Southwest 1/4 of the Southwest 1/4, Section 2, Township 29, Range 23; thence North 70 feet; thence East 40 rods; thence South 70 feet; thence West 40 rods to the point of beginning, except the East 160 feet thereof, lying East of the East line of Lexington Avenue.

- o Denotes Iron set.
- Denotes Iron found. Easements have not

been shown.

SCALE: 1" = 50', 9

East and West in the description are interpreted to mean parallel to the South line of the SW 1/4 of said Section. This agrees best with lines of occupancy and existing monumentation. Legal verification and check of adjoining descriptions is needed prior to acceptance.

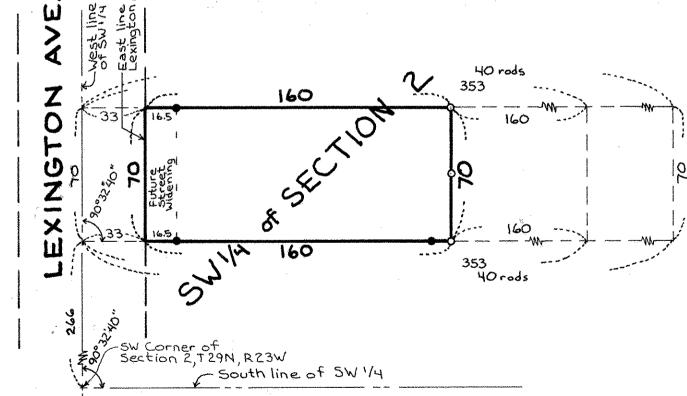

I hereby certify that this survey, plan plat, preliminary plat or report was prepared by me or under my direct supervision and that I am a duly Registered Land Surveyor under the laws of the State

of Minnesota.

10459 Reg No 8/6/92

R-92835

Book No.